


T. 24 S. R. 13 W. W.M.

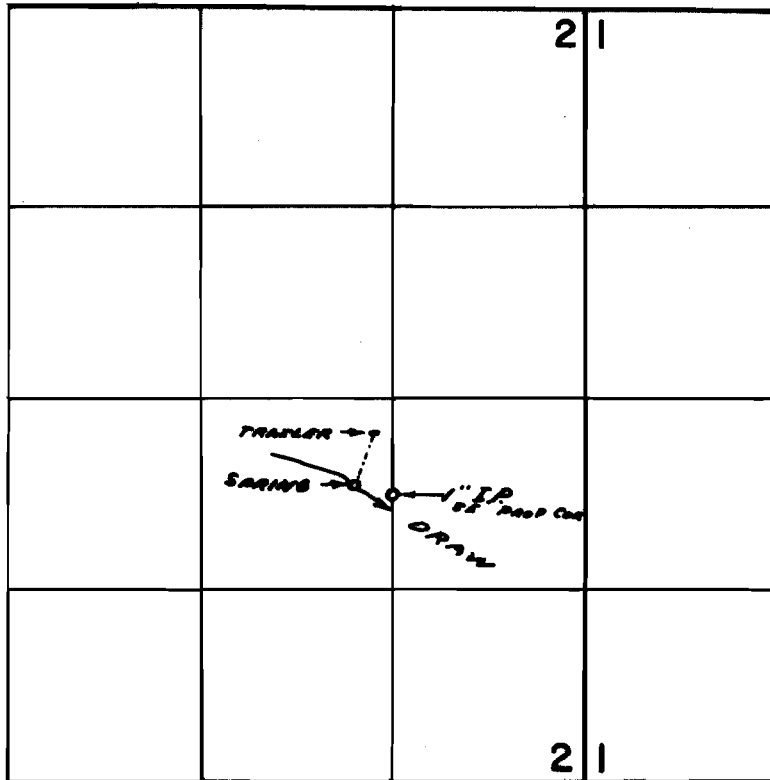

SPRING LOC. 250' W & 600' S FROM NE COR NW 1/4 SE 1/4 SEC. 2

FINAL PROOF SURVEY
UNDER

Application No. 45469 Permit No. 33930
IN NAME OF

W. D. MONGOLD

Surveyed AUG. 8, 1972, by R. G. MUCKEN