


T.27S., R.14W., W.M.

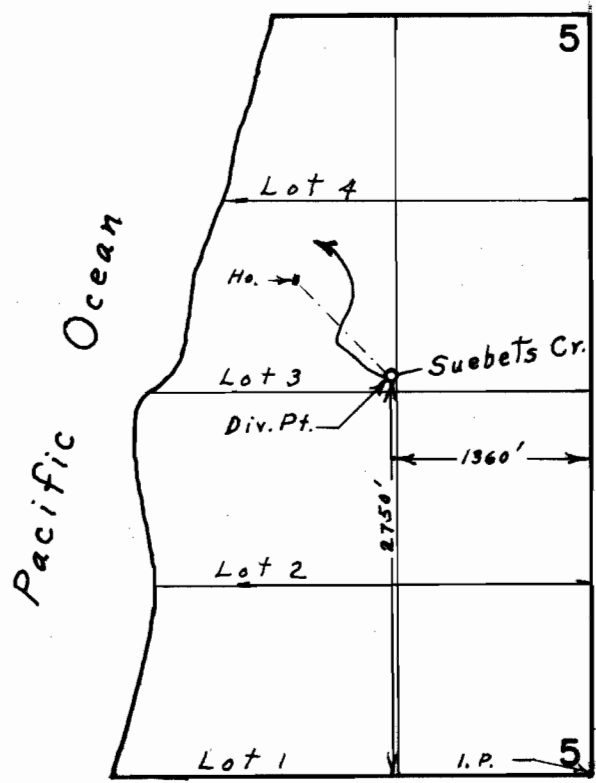

FINAL PROOF SURVEY
UNDER

Application No. 45605 Permit No. 33988
IN NAME OF

CHARLES W. & ELIZABETH M. SPEAR

Surveyed July 12, 1972, by L. E. Gould.