


# T.29 & 30S.R.12W.W.M.

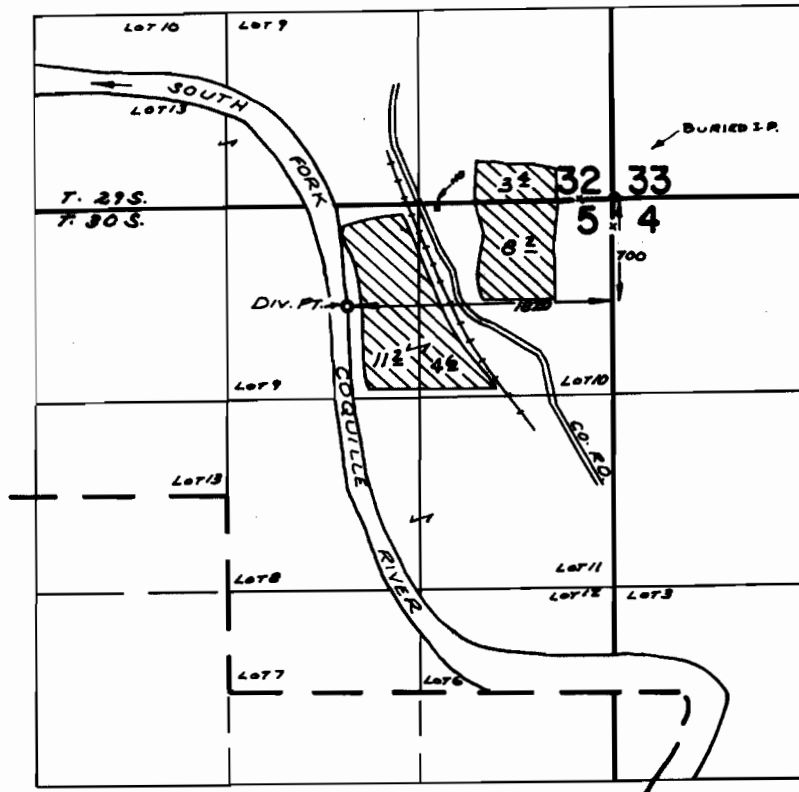

## FINAL PROOF SURVEY UNDER

Application No. 45894 Permit No. 34269  
IN NAME OF

MELVIN F. ELIZABETH STEWART

Surveyed JULY 11, 1972, by R. MUCKEN