


T. 26S. R. 12W. W.M.

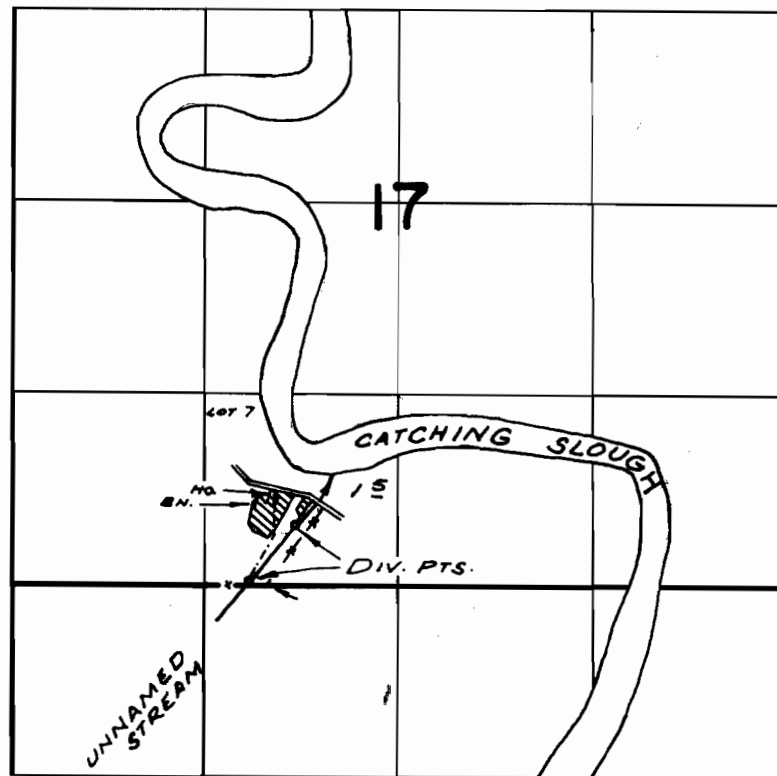

FINAL PROOF SURVEY
UNDER

Application No. 46008 Permit No. 34362
IN NAME OF

JAMES O. LOVE & PHYLLIS K. LOVE

Surveyed AUG. 3 1972, by R. MUGGEN