


T. 28 S. R. 14 W. W. M.

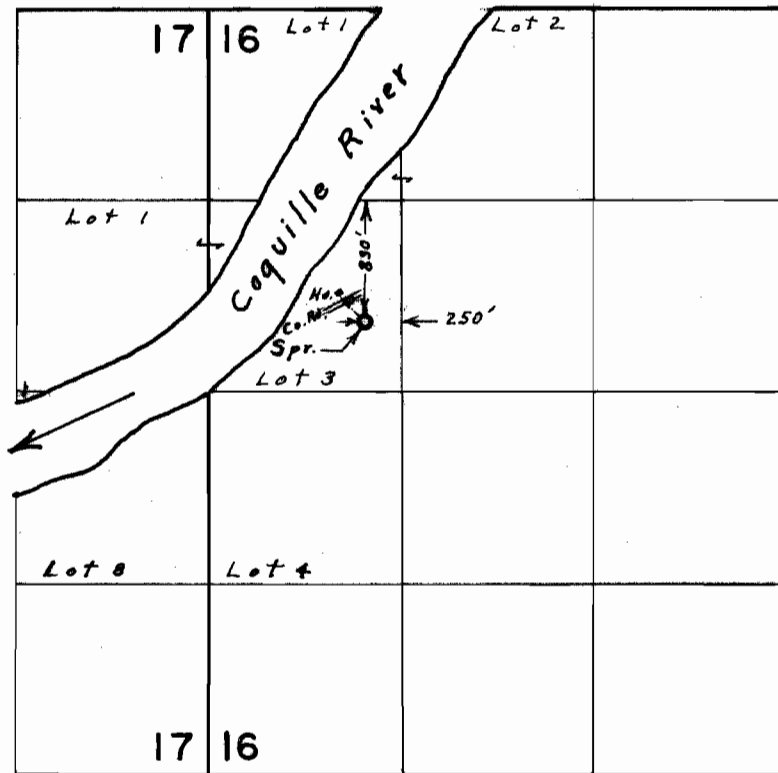

FINAL PROOF SURVEY
UNDER

Application No. 47060 Permit No. 35196

IN NAME OF

W. E. & LOUISE L. KIRSTEIN

Surveyed April 15, 1972, by L. E. Gould