


T. 23 S. R. 12 W. W. M.

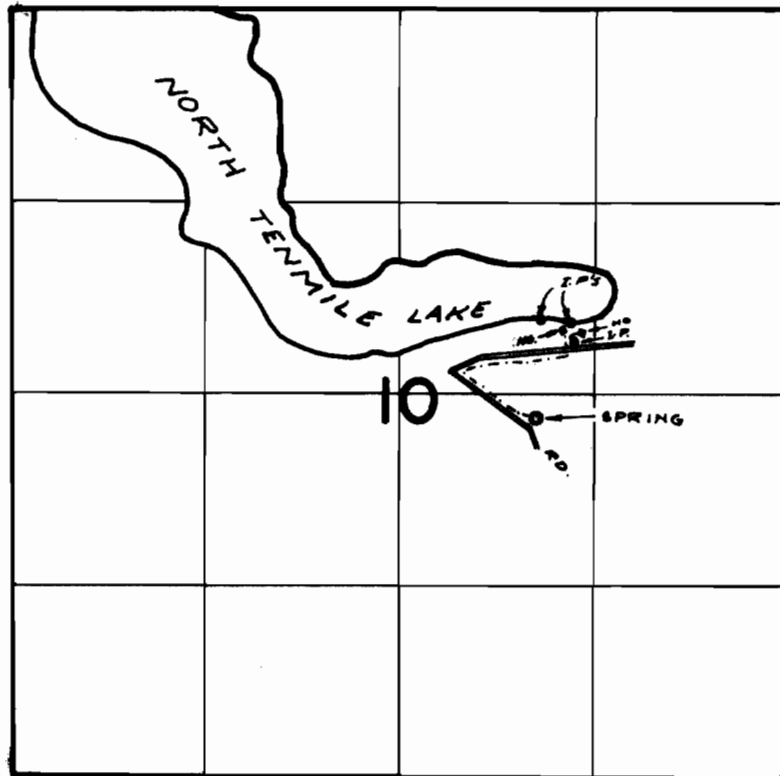

SPRING LOC: 160' S. & 930' E. FROM CEN. SEC. 10

FINAL PROOF SURVEY
UNDER

Application No. 47304 Permit No. 35214
IN NAME OF
FRED M. & AUDREY L. BRUEGGER &
SOUTH CASCADE CORPORATION

Surveyed AUG. 7, 1972, by R. MUCKEN