


T.26S.R.12W.W.M.

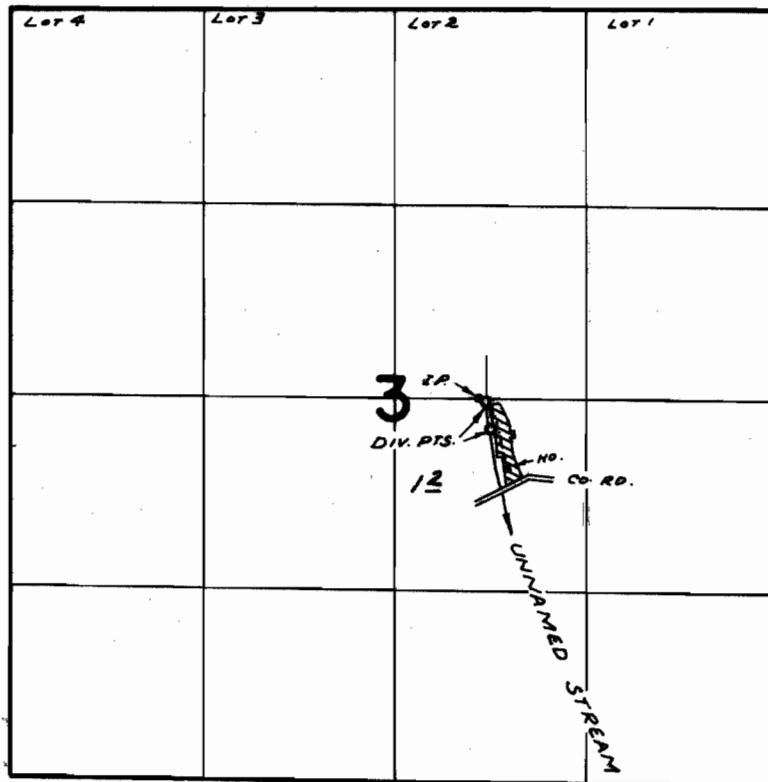

FINAL PROOF SURVEY
UNDER

Application No. 4768/ Permit No. 3523/
IN NAME OF

WILLIAM L. REEVES

Surveyed AUG. 1, 1972, by R. MUCKEN