


T.27S., R.13W., W.M.

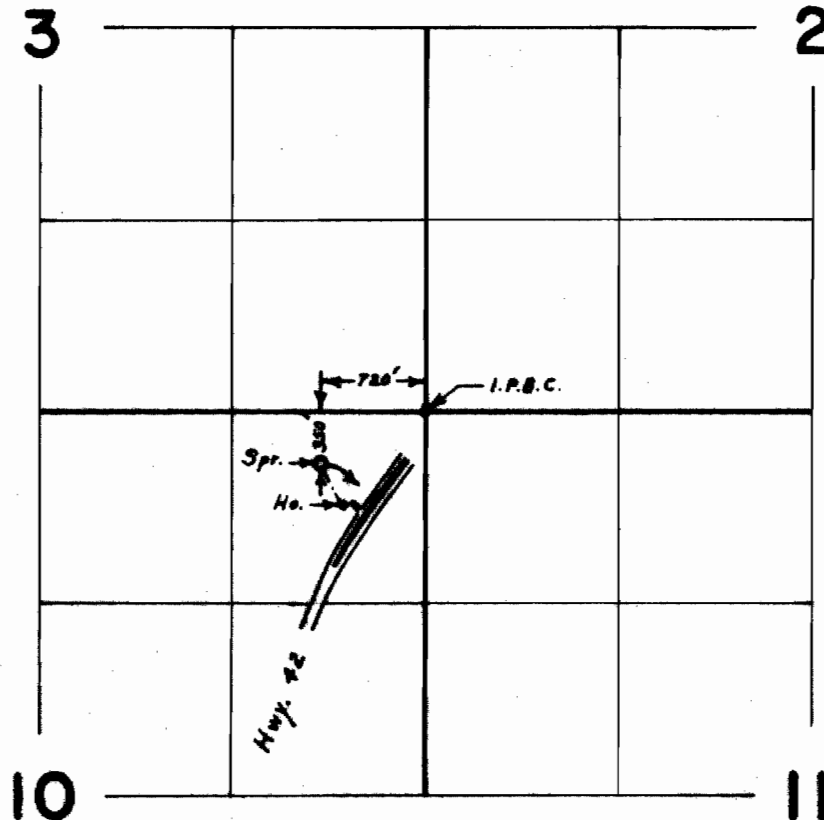

FINAL PROOF SURVEY
UNDER

Application No. 47798 Permit No. 35254
IN NAME OF

LAWRENCE C. & FAY F. CRABTREE

Surveyed July 13, 1972, by L. E. Gould