


T.25 S.R.12 W.W.M.

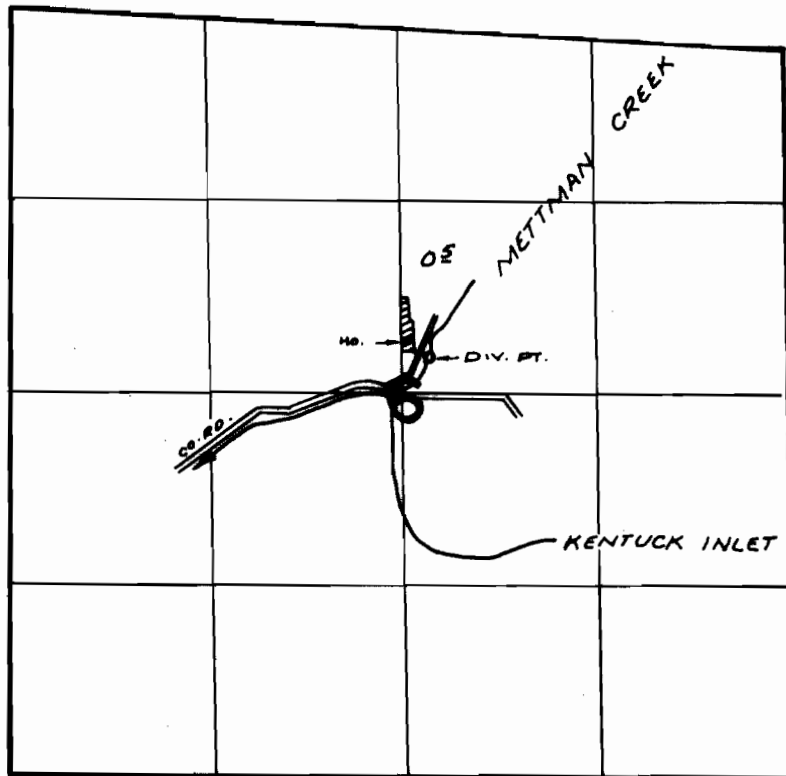

DIV. PT. LOC: 240' N. & 190' E. FROM CEN. SEC. 6

FINAL PROOF SURVEY UNDER

Application No. 47363 Permit No. 35477
IN NAME OF

JOHN A. & MERLE M. HANEY

Surveyed AUG. 1, 1972, by R. MCKEN