


T.29S.R.14W.W.M.

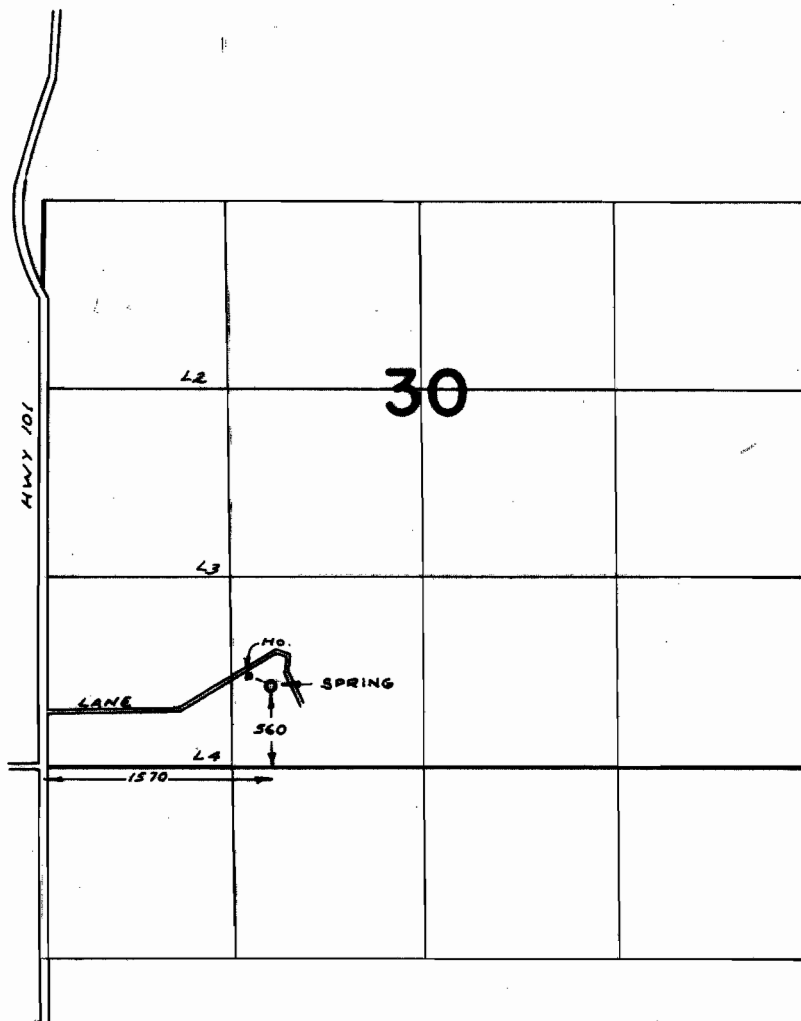

FINAL PROOF SURVEY
UNDER

Application No. 48074 Permit No. 35688
IN NAME OF

Leo M. Calahan

Surveyed JULY 15 1972, by R. MUCKEN