


T. 25 S. R. 4W. W.M.

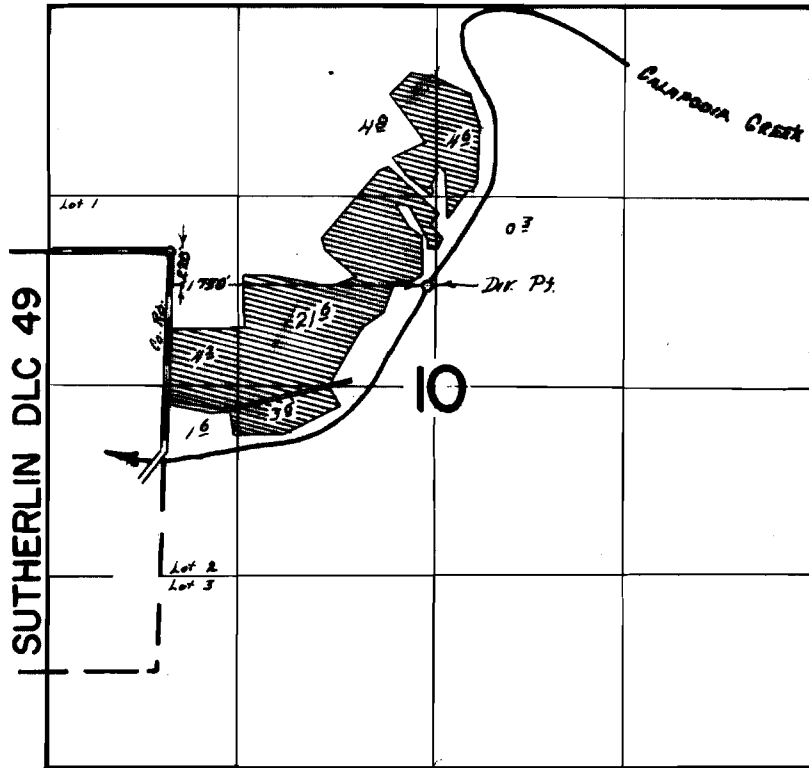

FINAL PROOF SURVEY
UNDER

Application No. 41822 Permit No. 31308
IN NAME OF

MARY ANN & VICTOR H. SCHRICKER

Surveyed June 29 1970, by M. J. YEUNGAUST