


T. 7 S. R. 28 E. W. M.

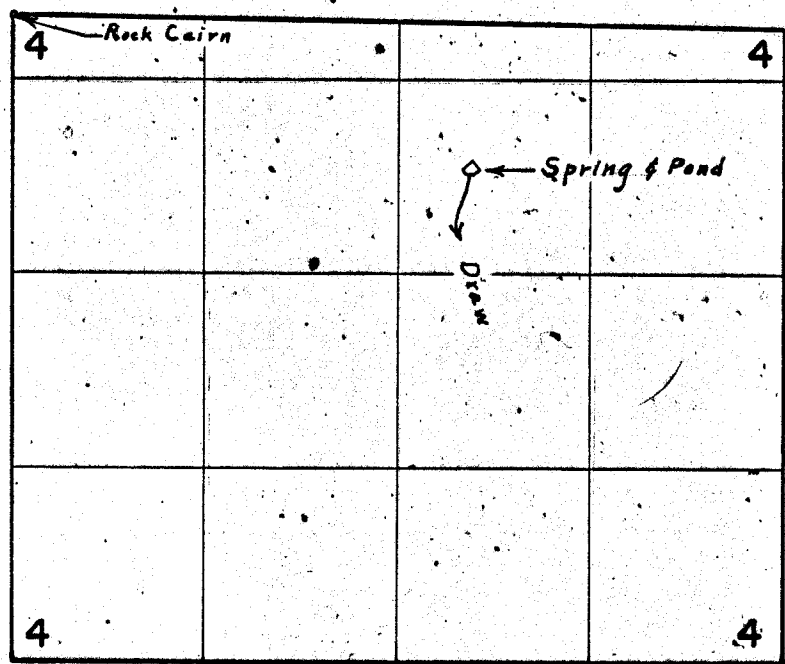

Spring located 1630' S. & 3130' E. from N.W. Cor. Sec. 4

FINAL PROOF SURVEY UNDER

Application No. 34736 Permit No. 27274

IN NAME OF
U. S. DEPARTMENT OF AGRICULTURE
FOREST SERVICE

Surveyed July 22, 1971, by L. E. Gould