


T. 24 S. R. 30 & 31 E. W. M

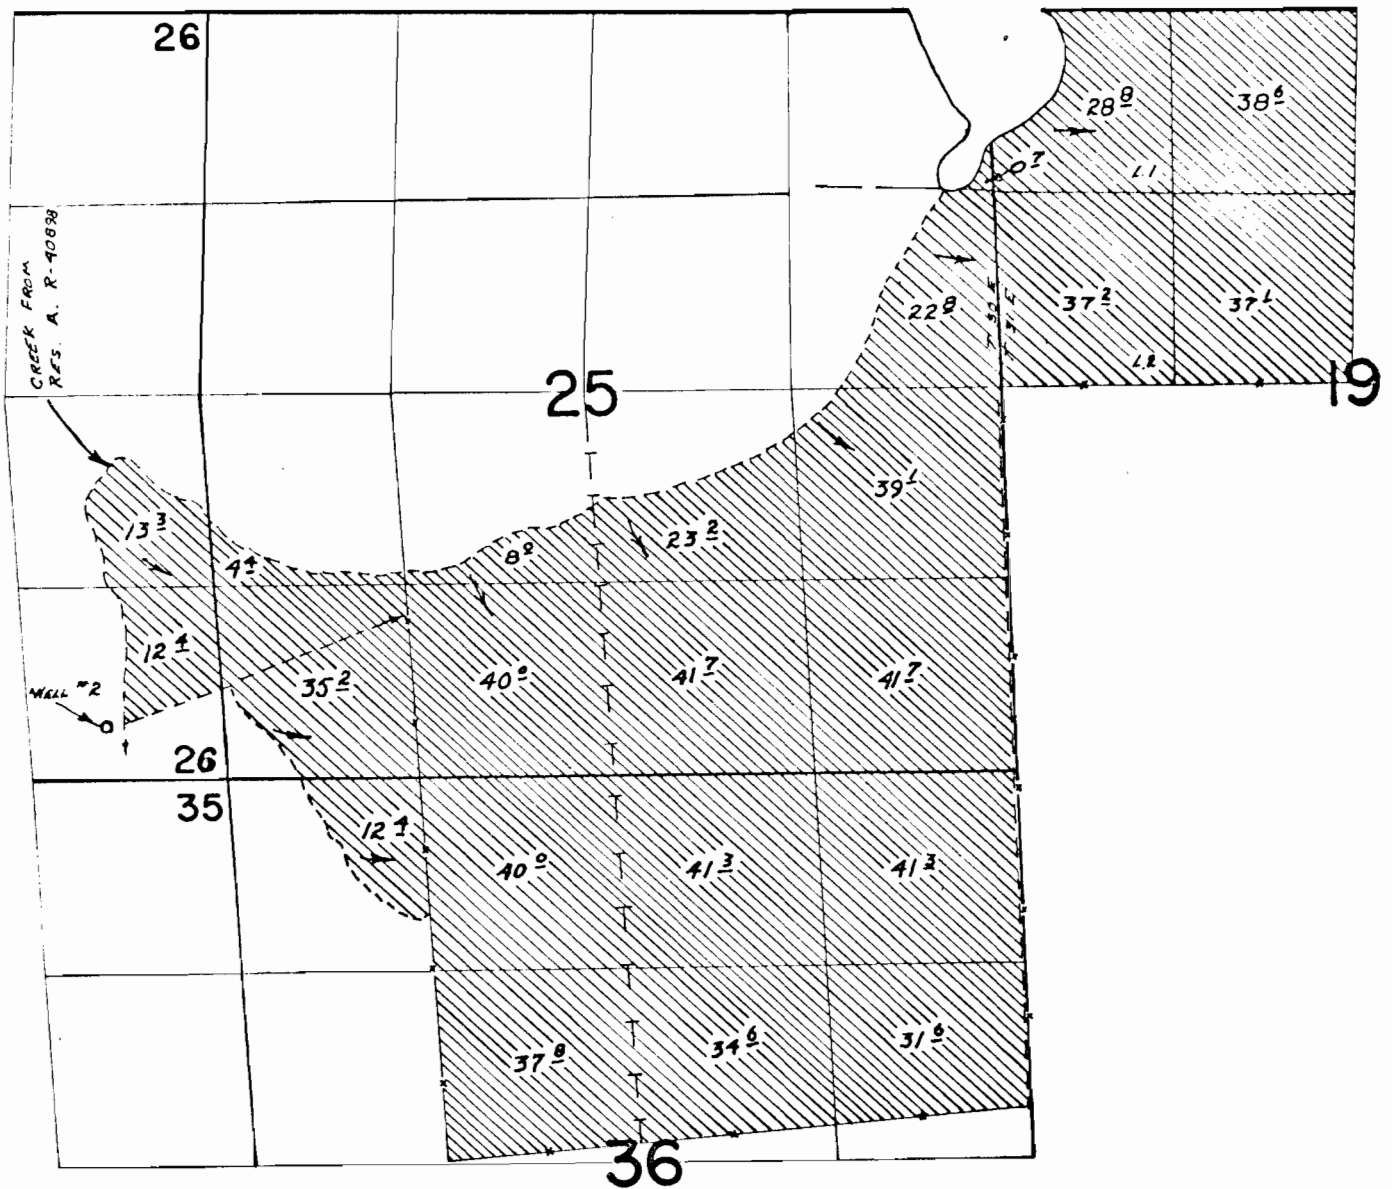

FINAL PROOF SURVEY UNDER

Application No. ⁴⁰⁸⁹⁹~~P. 10898~~ Permit No. ⁴⁰⁴³⁵~~R-4577~~
IN NAME OF

JOHN M. CAMPBELL

Surveyed ~~Aug 22 1972~~ 19.72, by ~~R. R. MUCKER~~