


29876

T.2N.R.10E.W.M.

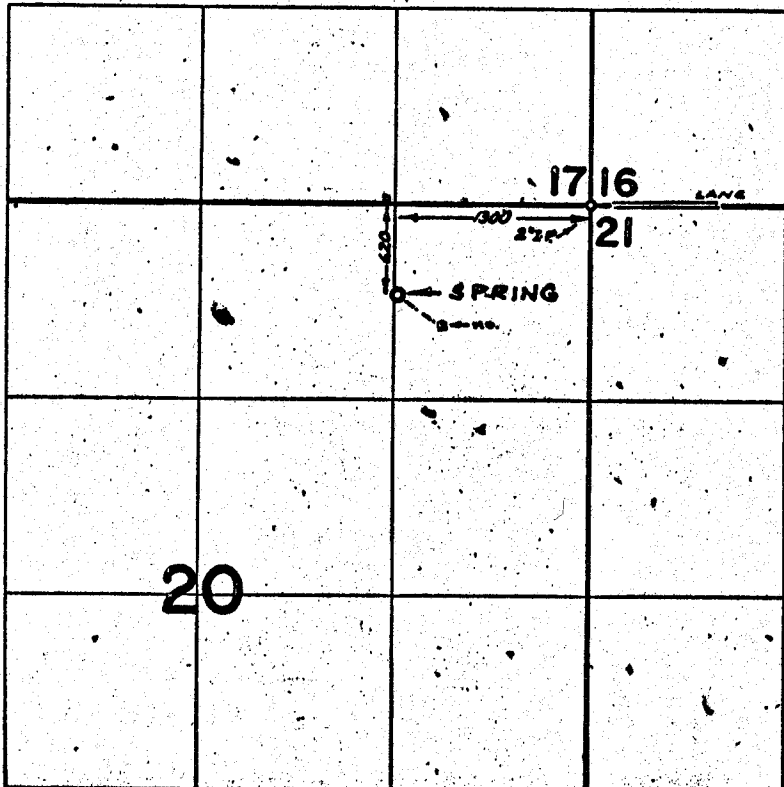

FINAL PROOF SURVEY UNDER

Application No. 40101 Permit No. 29876
IN NAME OF

RICHARD A. & PATRICIA A. SCHMUCK

Surveyed APR. 24, 1971, by G. BACA

Permit # 29876

R.S.M.
1971-A

C-39438