


T. 39S.R.3W. W.M.

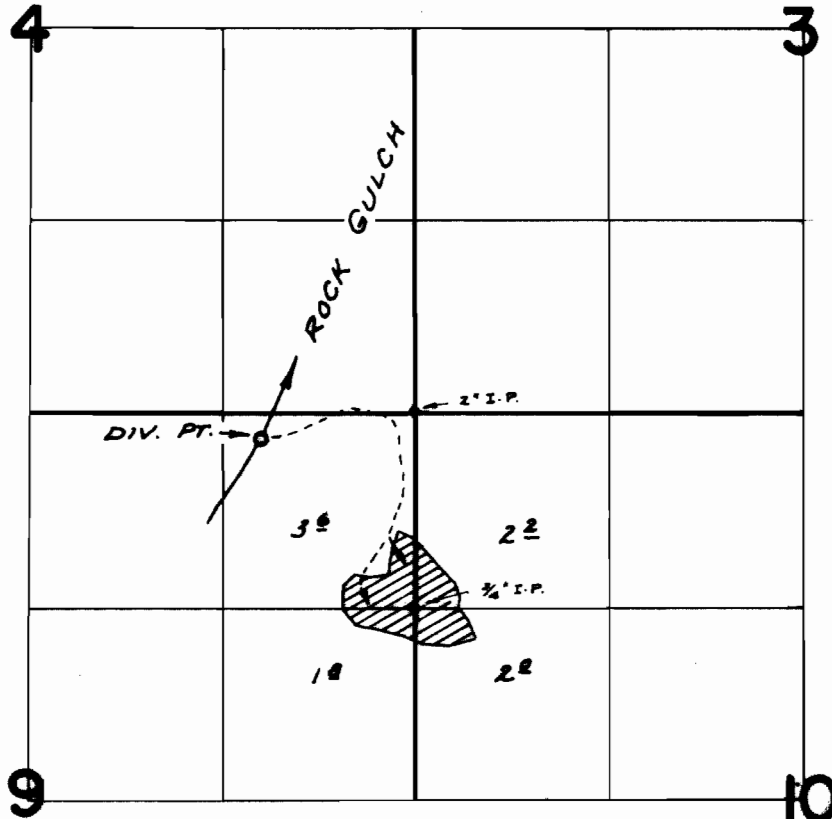

DIV. PT. LOC: 170'S. & 1070' W. FROM N.E. COR. SEC. 9

FINAL PROOF SURVEY
UNDER

Application No. 41203 Permit No. 30810
IN NAME OF

MARTIN S. GRIER

Surveyed AUG. 9, 1971, by G. BACA