


T.5S. R.1W. W.M.

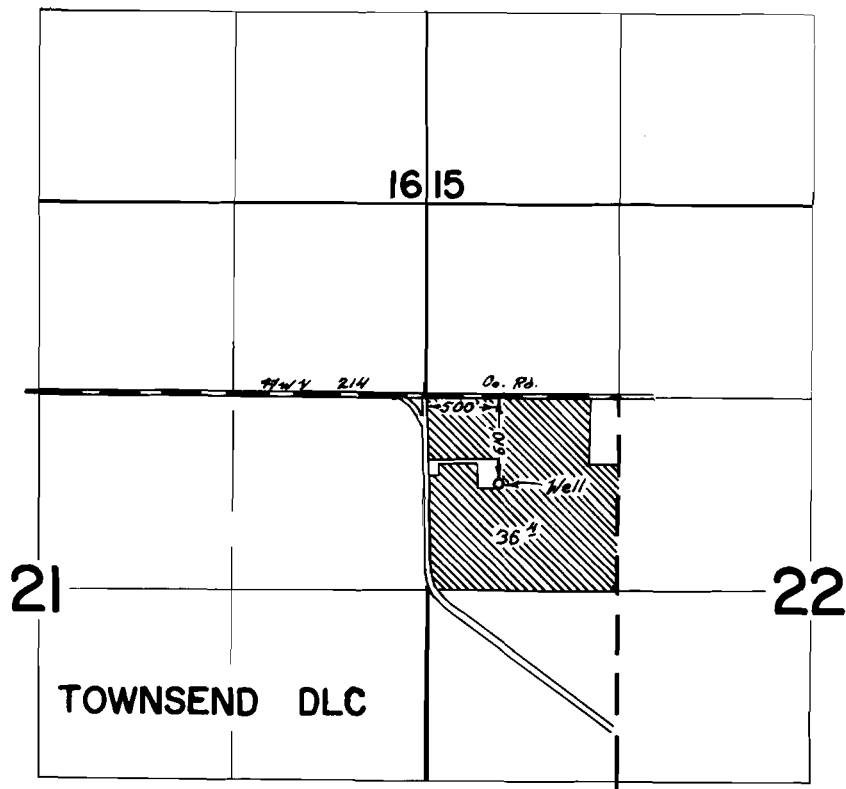

FINAL PROOF SURVEY
UNDER

Application No. G-4466 Permit No. G-4209
IN NAME OF

BERNHAND & PATRICIA HITZ

Surveyed Aug. 17 1972, by P. B. Mucken