


T. 6 S. R. 2 W. W. M.

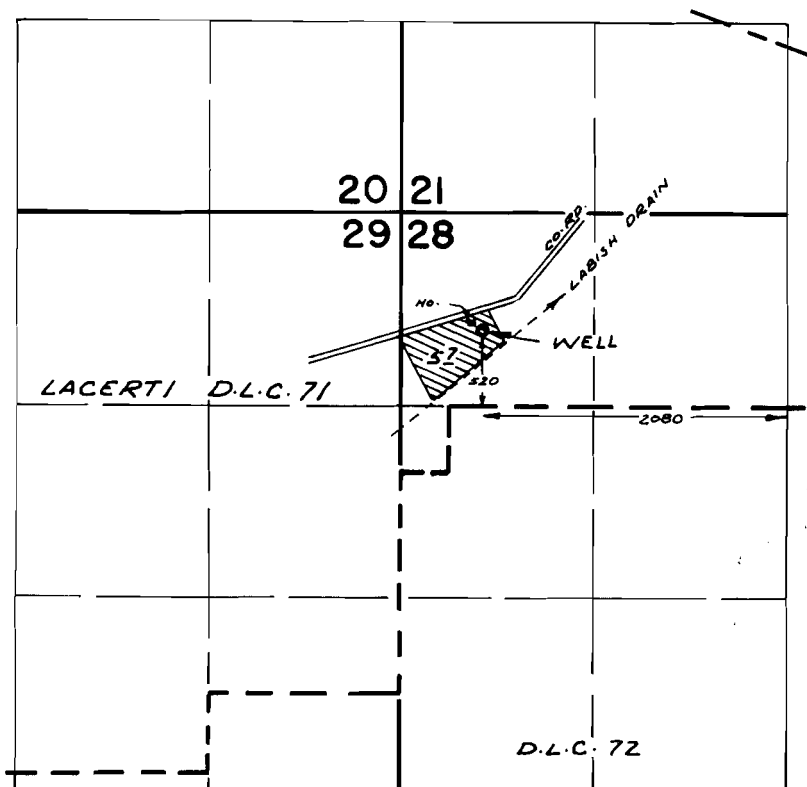

FINAL PROOF SURVEY UNDER

Application No. G-4508 Permit No. G-4249
IN NAME OF

BEVERLY and LAURA M. WILLIAMS

Surveyed APR. 4, 1972, by R. MUGGEN