


T.6S.R.7W.W.M.

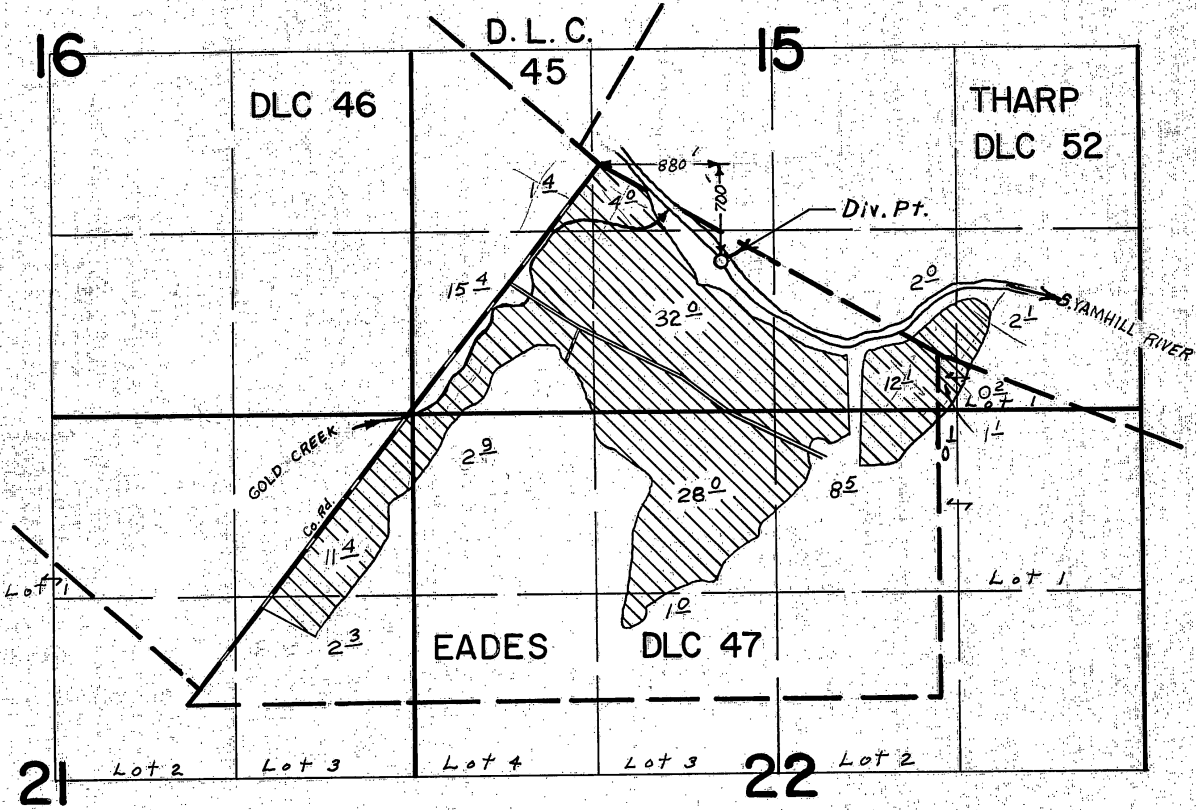

FINAL PROOF SURVEY UNDER

Application No. 44848 Permit No. 33488  
IN NAME OF

JOHN E. & JEAN N. THOMPSON

Surveyed SEPT 28 1972, by L. GOULD