


T.8S. R.6W. W.M.

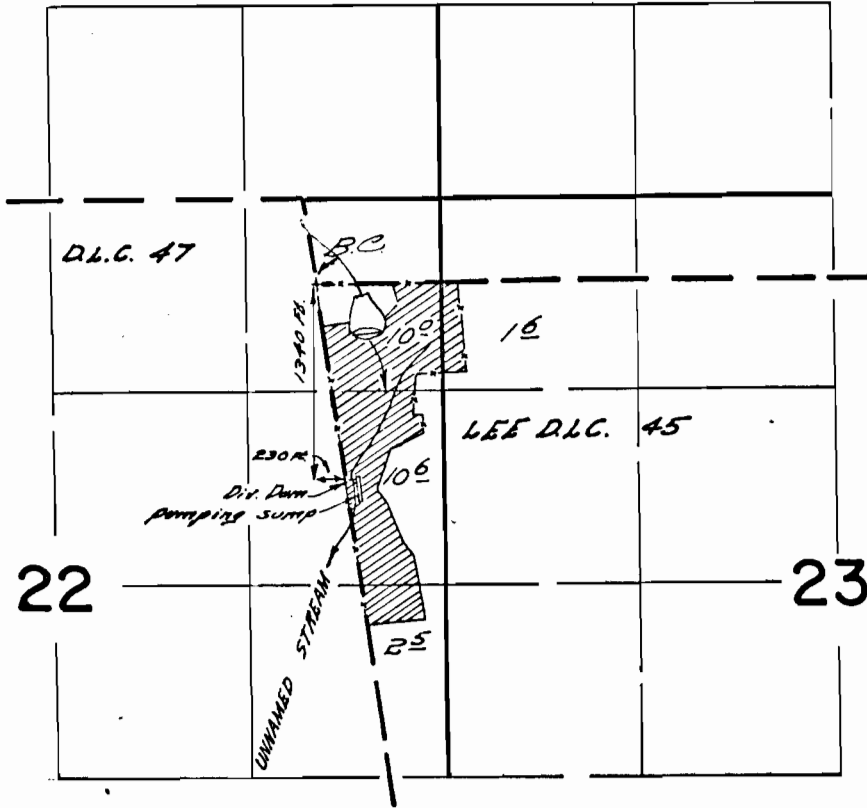

FINAL PROOF SURVEY UNDER

Application No. 37624.. Permit No. 22057...
IN NAME OF

.....*ELDON R. FRINK*.....

Surveyed *Sept. 6...* 1968, by *W. J. Ruppert*