


# T. 7 S. R. 4 W. W. M.

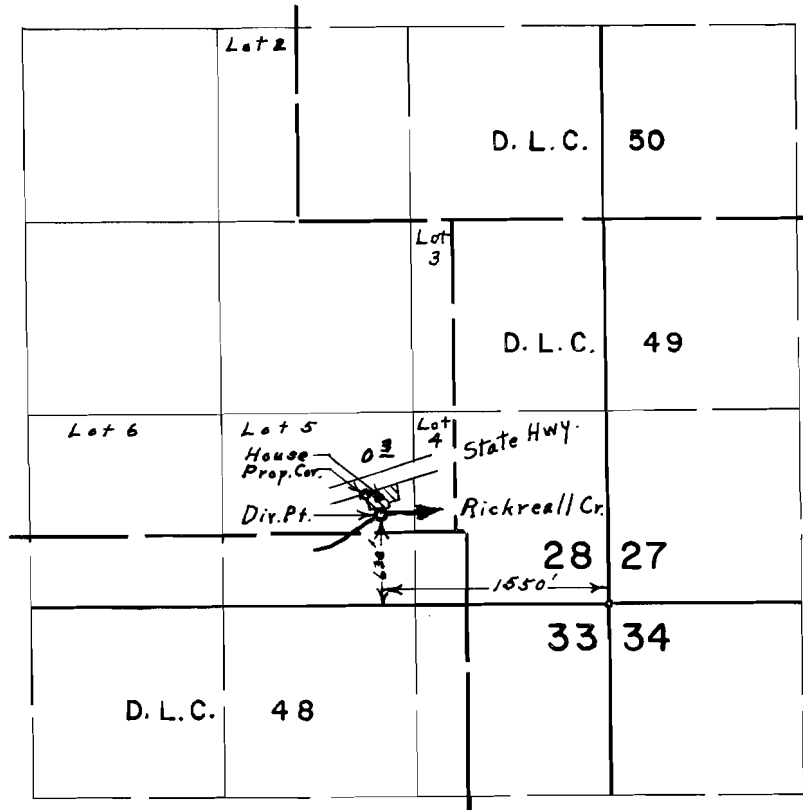

## FINAL PROOF SURVEY UNDER

Application No. 46348. Permit No. 34625.  
IN NAME OF

EARL C. & BERENICE M. RIHA

Surveyed April 6, 1972., by L. E. Gould.