


# T.6S.R.7W.W.M.

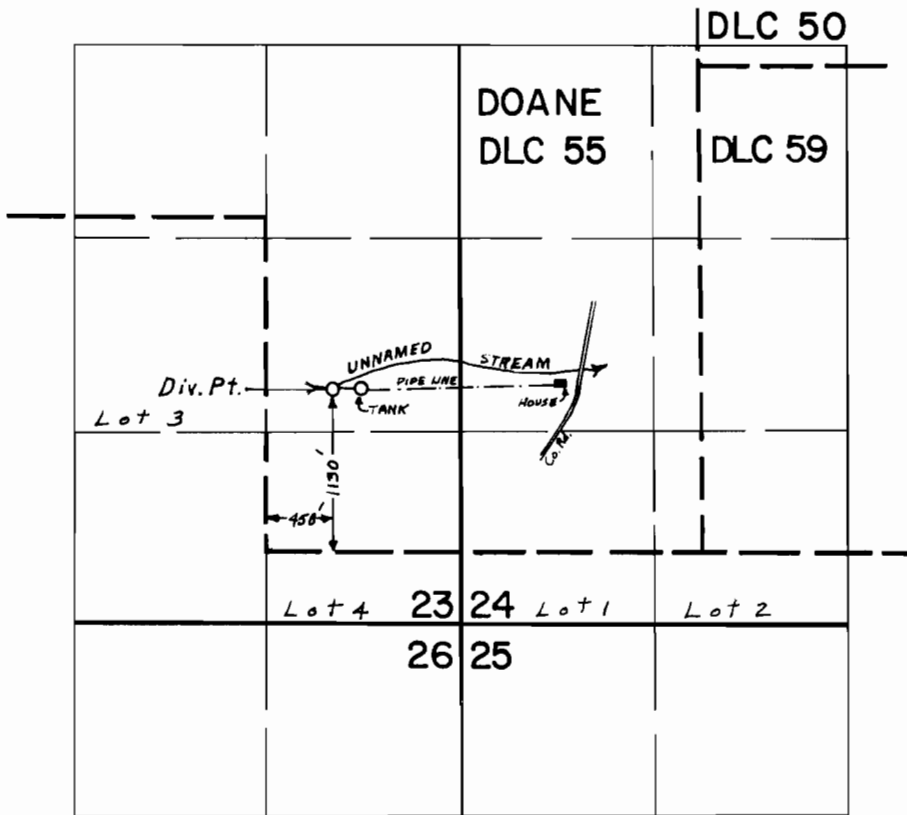

## FINAL PROOF SURVEY UNDER

Application No. 46621 Permit No. 34838  
IN NAME OF

ROBERT FOSS MORTON

Surveyed SEPT 26 1972, by L. GOULD