


T. 7 S. R. 4 W. W.M.

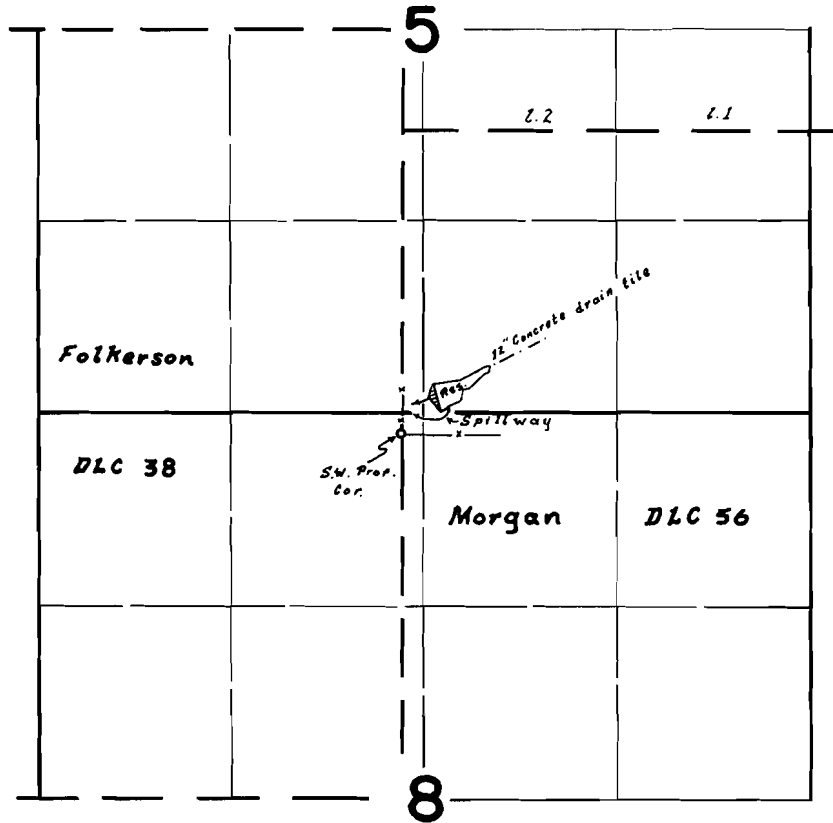

Div. Pt. Loc. 100' N. & 75' E. from S. $\frac{1}{4}$ Cor. Sec. 5

FINAL PROOF SURVEY
UNDER

Application No. R-43553 Permit No. R-5001
IN NAME OF
John W. Rice

Surveyed 14 June 1972 by L. E. Gould