


T. 7 S. R. 5 W. W.M.

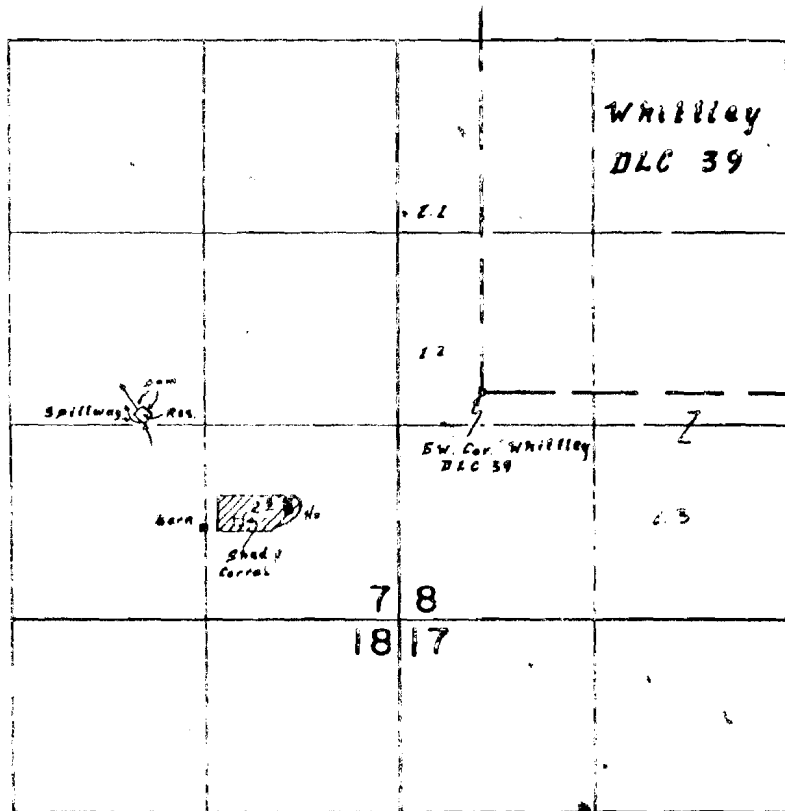

Dam loc. 120' S. of 2300' W. from SW. Cor. Whitley DLC 39

FINAL PROOF SURVEY
UNDER

R-43581

R-5006

Application No. 43582 Permit No. 32590

IN NAME OF

Marvin J. Weiser

Surveyed 16 Aug 1972, by L.E. Gould