



T. 6 & 7 S. R. 5 W. W.M.

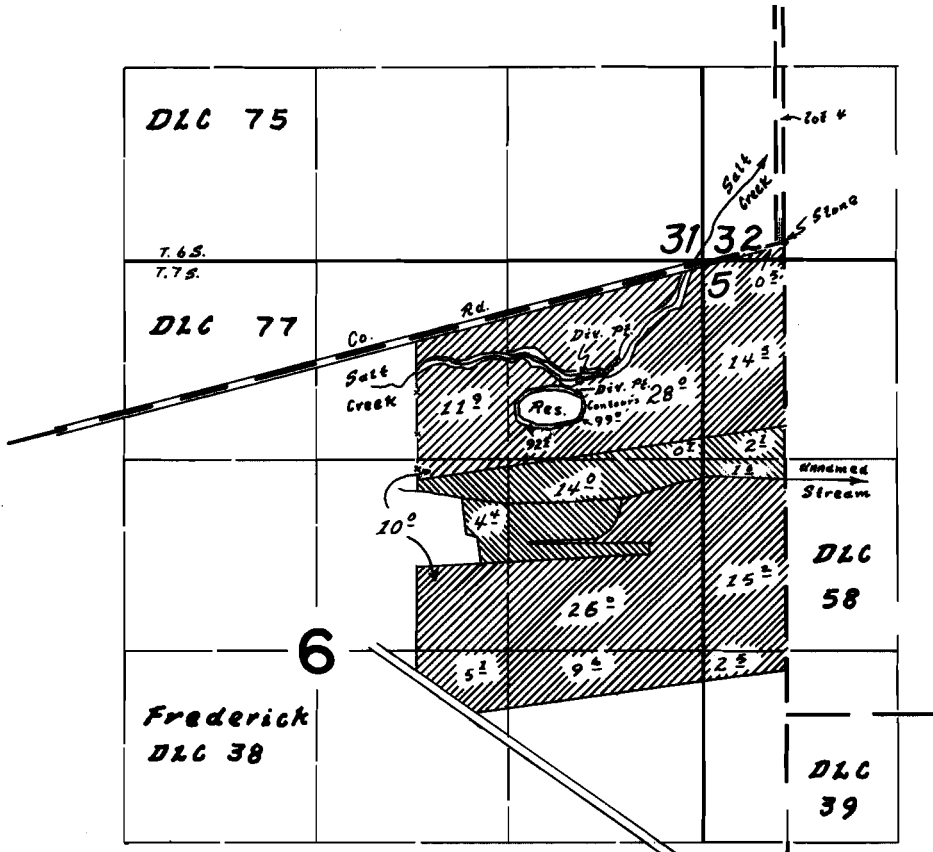

Div. Pt. from Salt Cr. 950'S. & 1420'W. } All Loc. from NE. Cor.
 Div. Pt. from Reservoir 1030'S. & 1430'W. } Frederick DLC 38

Primary 

Supplemental 

FINAL PROOF SURVEY UNDER

Application No. R-44493 Permit No. R-5269
44494 33300

IN NAME OF
John Hoekstre

Surveyed 30 Aug. 1972 by L.E. Gould