


# T. 6 & 7 S. R. 5 W. W.M.

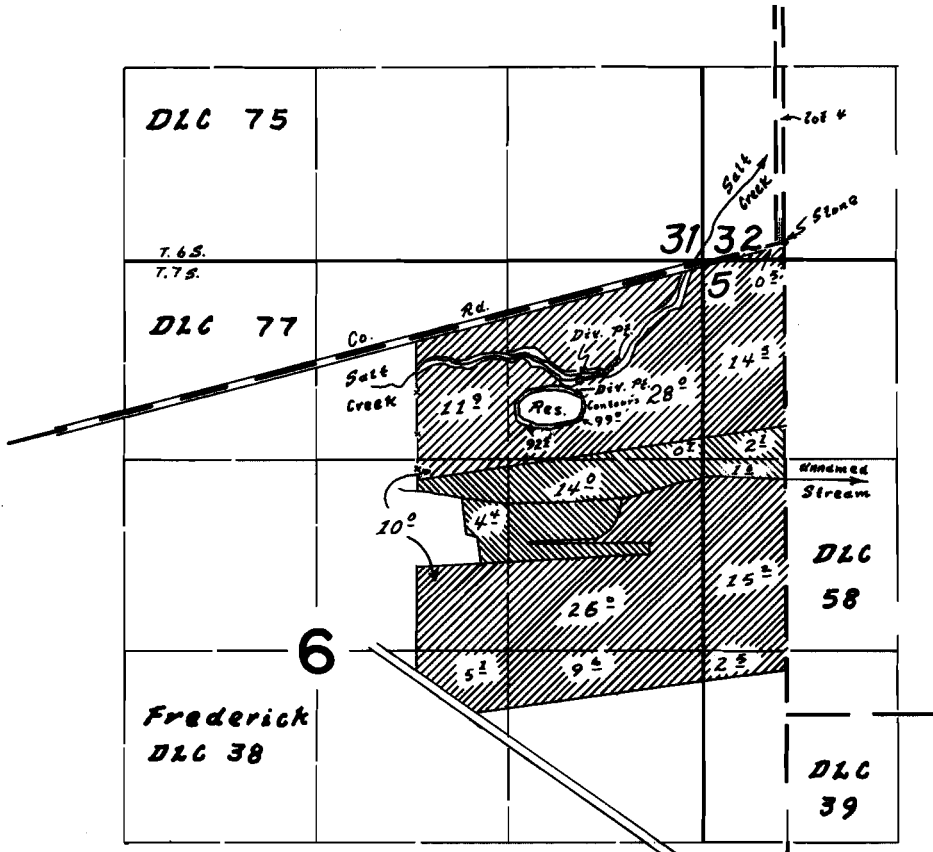

Div. Pt. from Salt Cr. 950'S. & 1420'W. } All Loc. from NE. Cor.  
 Div. Pt. from Reservoir 1030'S. & 1430'W. } Frederick DLC 38

Primary   
 Supplemental 

## FINAL PROOF SURVEY UNDER

Application No. R-44493 44494 Permit No. R-5269 33300

IN NAME OF  
*John Hoekstre*

Surveyed 30 Aug. 1972 by L.E. Gould