


T.8S. R.6W. W.M.

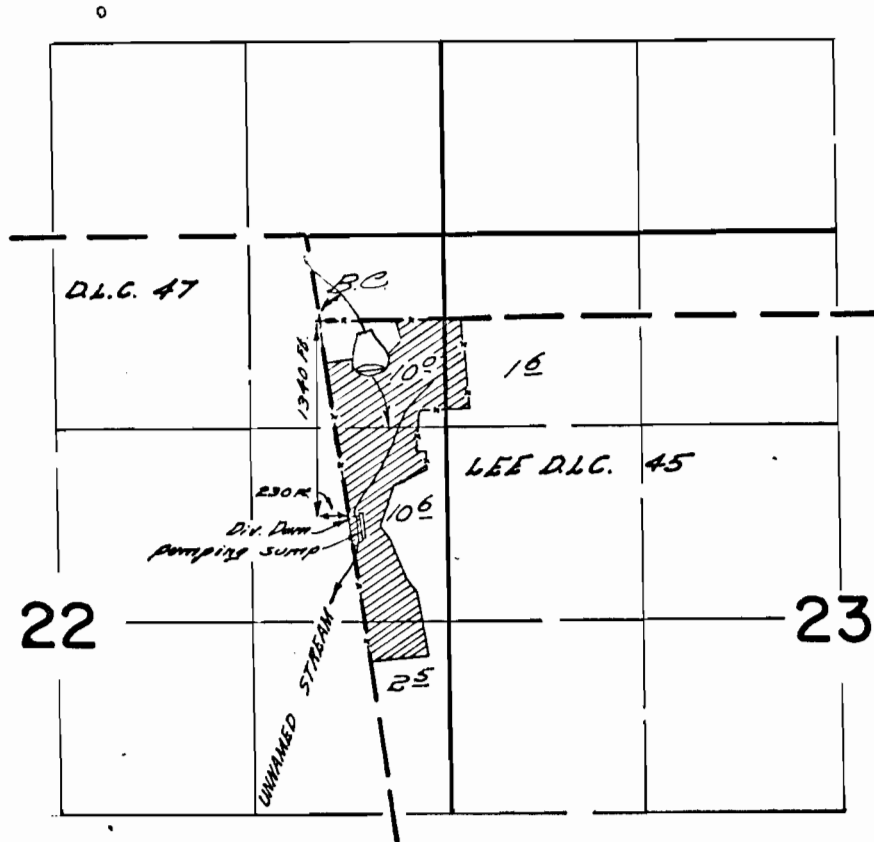

FINAL PROOF SURVEY
UNDER

Application No. 37624. Permit No. 28057.
IN NAME OF

ELDON R. FRINK

Surveyed Sept. 5, 1968, by W. J. Ruppert