


# T. 6 S., R. 5 W., W.M.

CONNERS

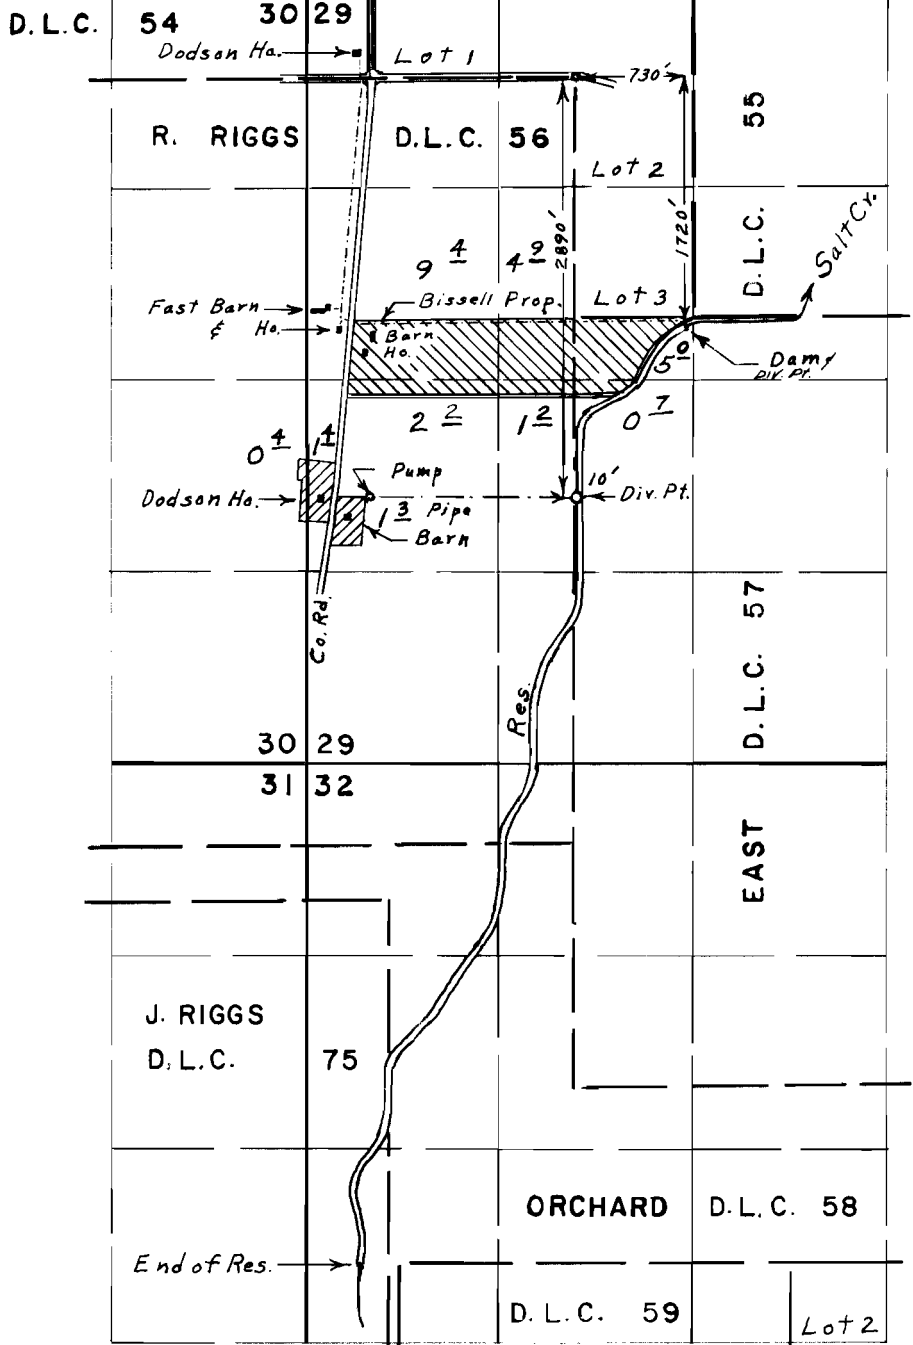

## FINAL PROOF SURVEY UNDER

R-45049                      R - 5357  
 Application No. 45050      Permit No. 33853

IN NAME OF  
**G. J. BISSELL,**  
**R. C. DODSON, & MARVIN FAST**

Surveyed May 23, 1972, by L. E. Gould.