


T.7S. R.5 & 6W., W.M.

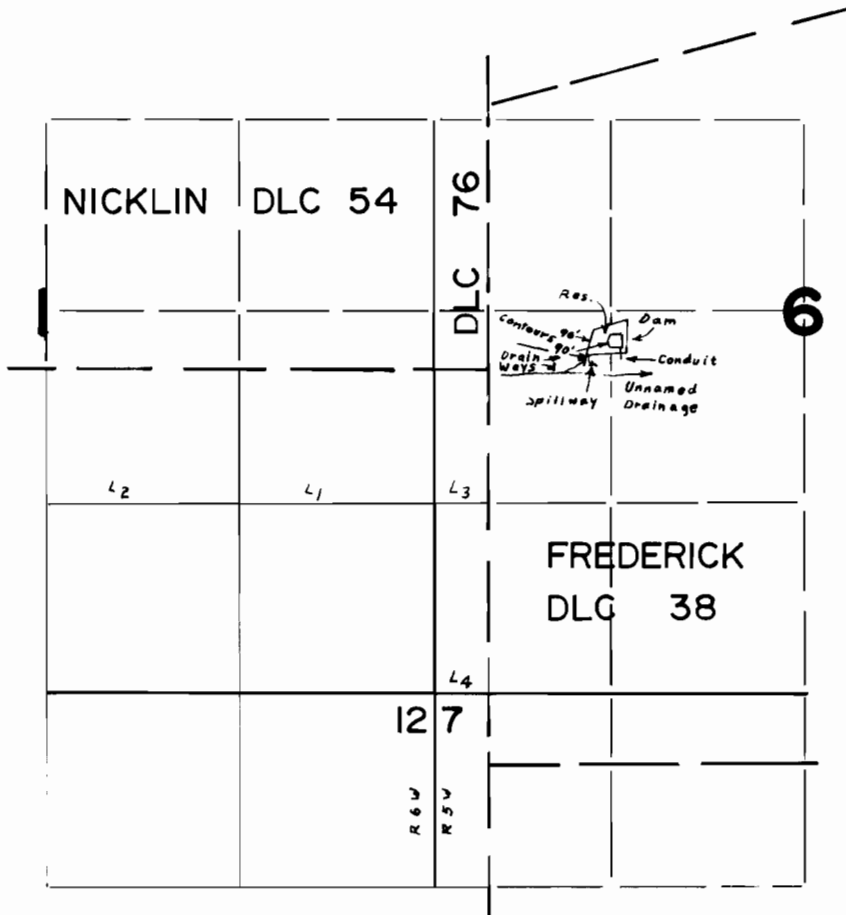

Dam Loc. 120' N. & 920' E. From S.E. Cor. Nicklin DLC 76

FINAL PROOF SURVEY UNDER

Application No. R-46082 Permit No. R-5483
IN NAME OF

ALVIN AEBI

Surveyed SEP. 1 1972, by L. E. GOULD