


T. 7 S. R. 4 W. W.M.

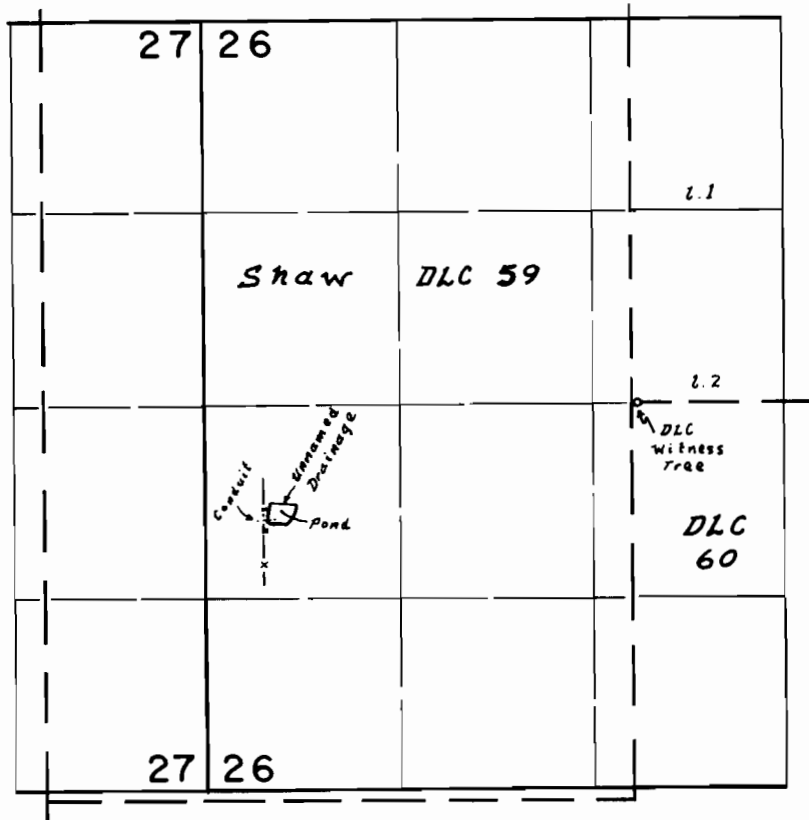

Div. Pt. Loc. 1940' N. & 1530' E. from S.W. Cor. Shaw DLC 59

FINAL PROOF SURVEY
UNDER

Application No. R-47482 Permit No. R-5721
IN NAME OF

Curtis Loewen

Surveyed 15 June 1972, by L.E. Gould