


T.2N. R.33E. W.M.

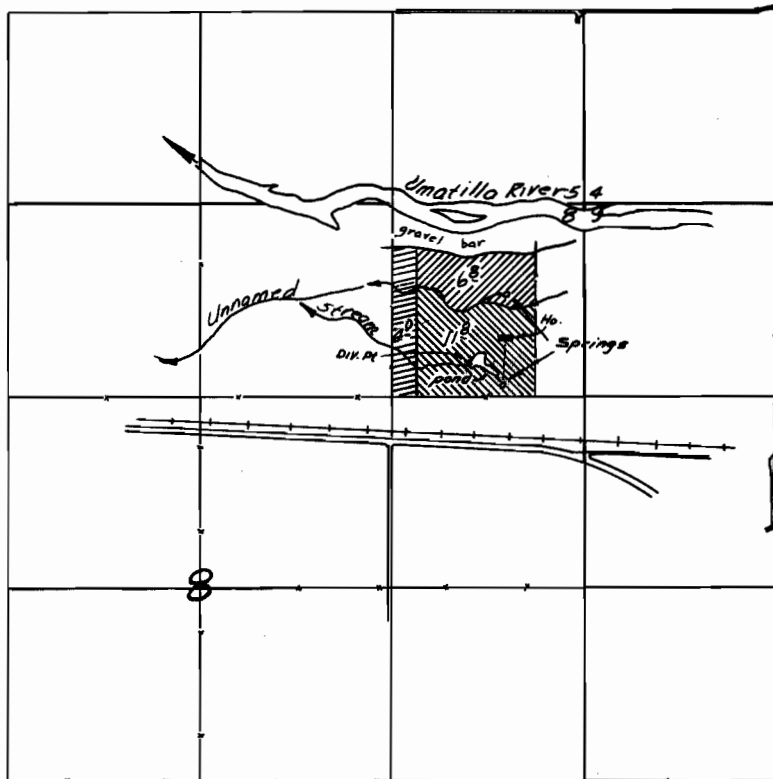

Springs located: 80 ft. N. & 750 ft. E., 710 ft. N. & 780 ft. E., D.I.K. Pt. 230 ft. N. & 520 ft. E., all from the SW. corner. NE 1/4 NE 1/4 Section 8



28813
30574
30603

FINAL PROOF SURVEY
UNDER

Application No. ³⁸⁶⁴⁵~~41007~~ ²⁸⁸¹³~~30574~~ Permit No. ³⁰⁶⁰³
IN NAME OF

DONALD N. & LILLIAN A. GRAY

Surveyed April 14, 1973, by D. Norby