


T. 3 S. R. 45 E. W. M.

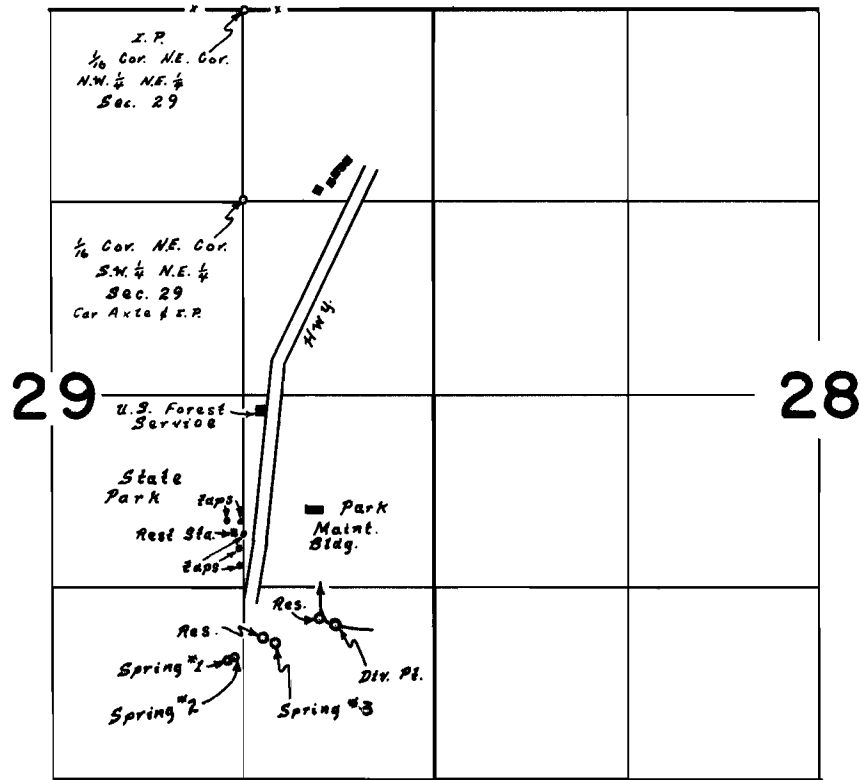

Springs #1 3160' S. & 120' W.
 #2 3140' S. & 60' W.
 #3 3040' S. & 220' E.
 E. Fork Wallowa Riv. Div. Pt. 2920' S. & 640' E. } All loc. from NE Cor. SW 1/4 NE 1/4 Sec. 29

FINAL PROOF SURVEY
 UNDER

Application No. 39336 Permit No. 29353

IN NAME OF

V.A. Searles & Ralph D. Watson
Upper Wallowa Lake Water District

Surveyed 23 June 1972, by L.E. Gould