


T.4S., R.3W., W.M.

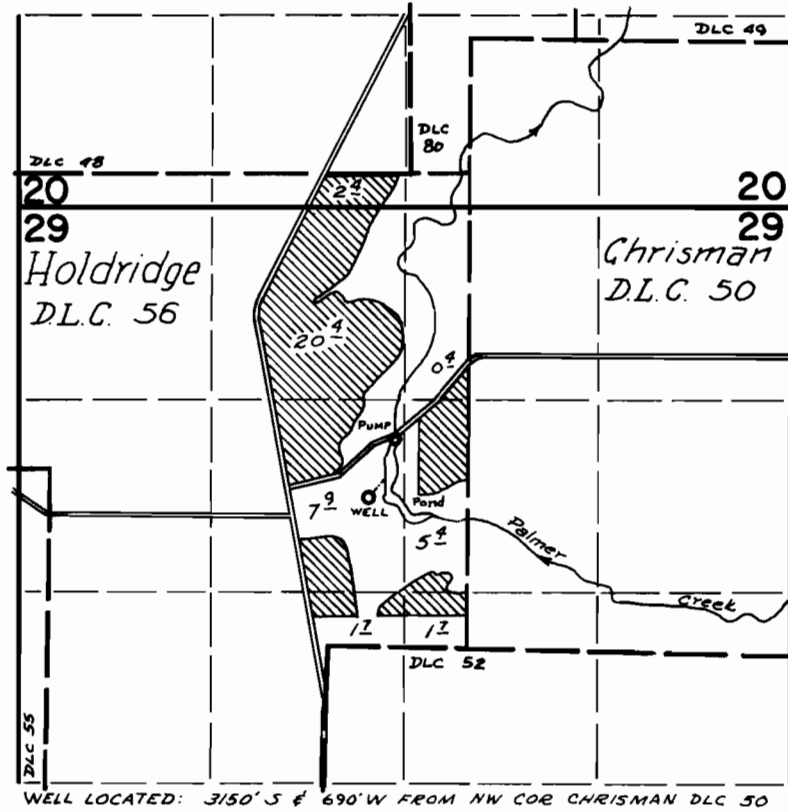

**FINAL PROOF SURVEY**  
UNDER

Application No. G-4191 Permit No. G-4053  
IN NAME OF

FRANCIS L. PATTERSON

Surveyed Oct. 27, 1972, by D. Norby