


T.4S., R. 4W., W.M.

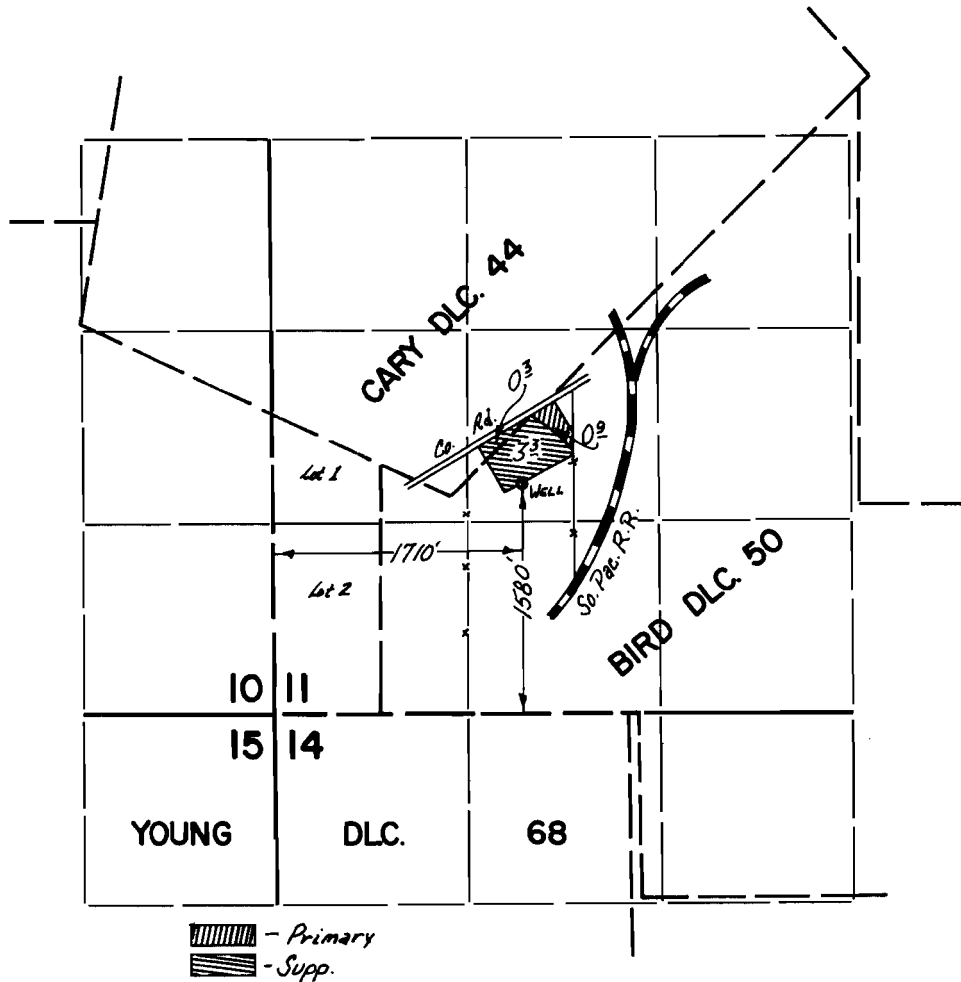

**FINAL PROOF SURVEY**  
UNDER

Application No. G-4715 Permit No. G-4439  
IN NAME OF

PAUL YOUNGMAN

Surveyed 16 Nov. 1972, by D. NORBY