


T.5S., R.5W., W.M.

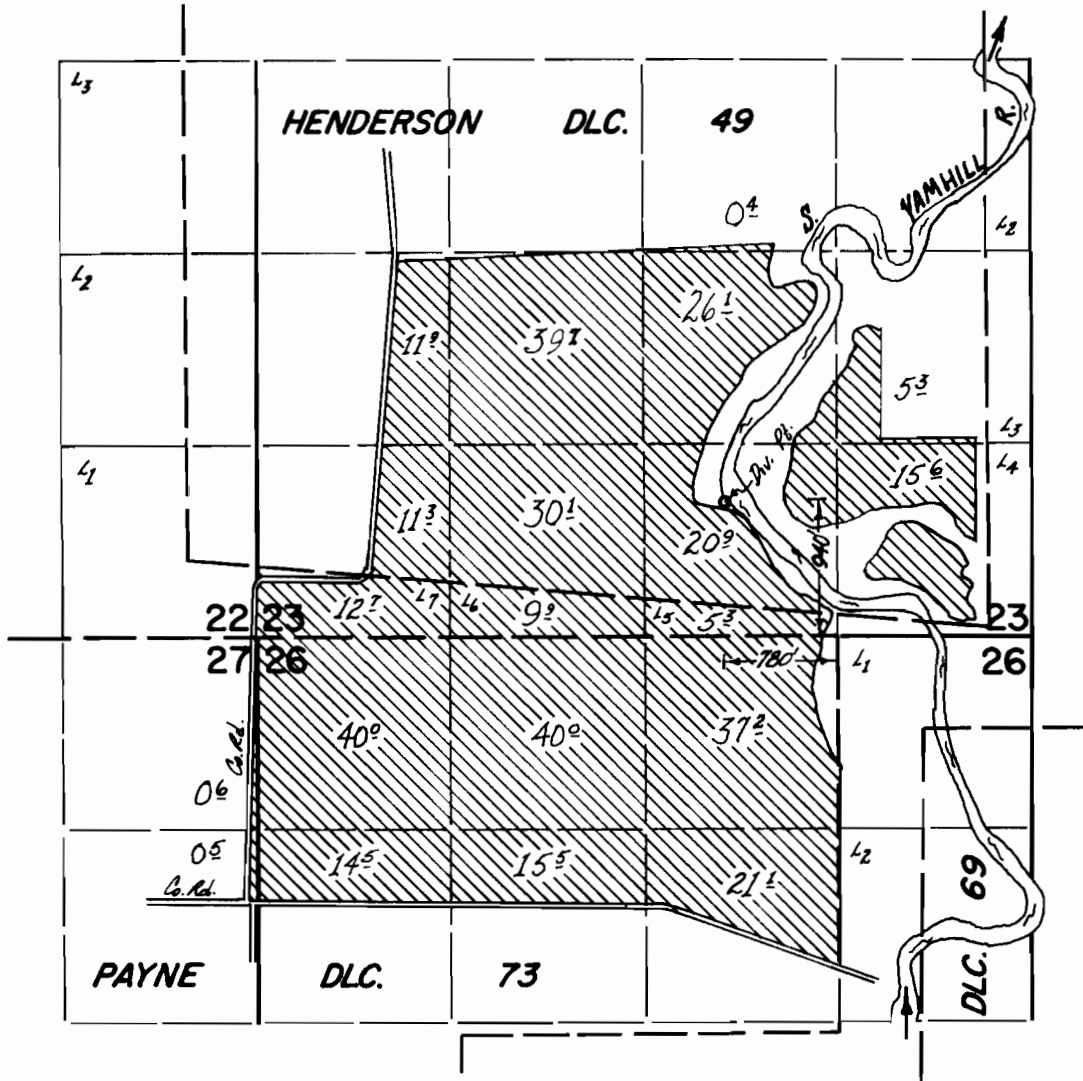

FINAL PROOF SURVEY
UNDER

Application No. 34685 Permit No. 27237
IN NAME OF

STEVE R. JONES

Surveyed 28 July 1972 by D. NORBY