



T. 5 S., R. 4 W., W.M.

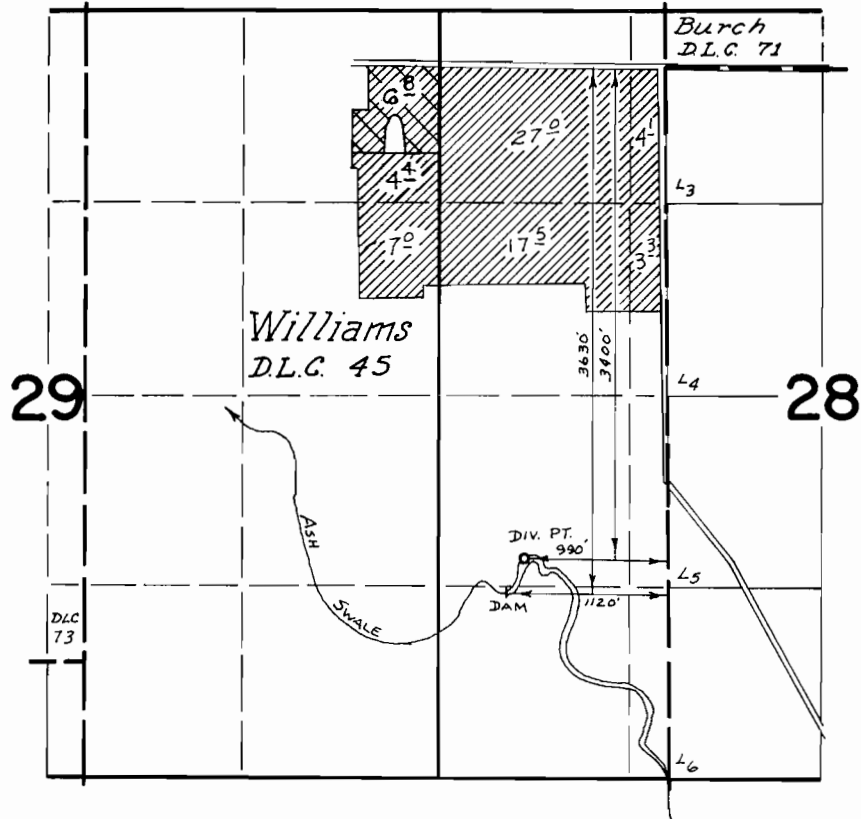


FINAL PROOF SURVEY UNDER

	51672	38535	
	40250	29822	
Application No.	47062	Permit No.	35/98
IN NAME OF			

ESTATE OF IVAN C. ROBISON

Surveyed May 15 1972 by D. Norby
June 7 1976 by R.G. Mucken

T. 5 S., R. 4 W., W.M.

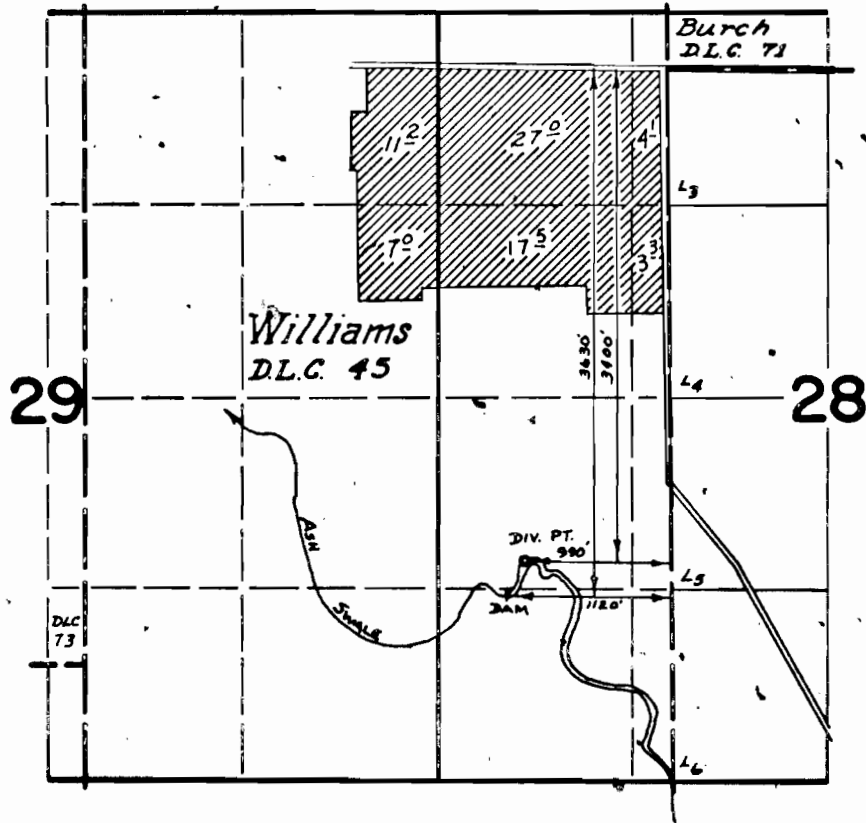

FINAL PROOF SURVEY UNDER

Application No: 40250 47062 Permit No. 29822 35198
IN NAME OF

IVAN C. ROBISON

Surveyed May 13 1972, by D. Norby