


T.4S., R.4W., W.M.

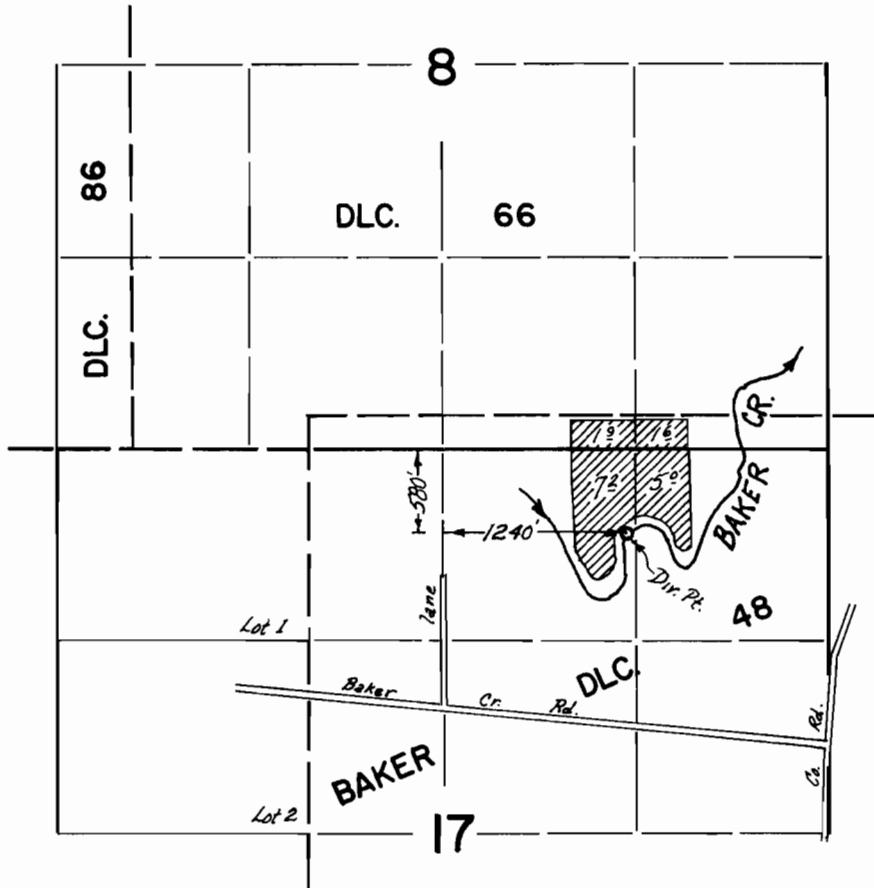

FINAL PROOF SURVEY
UNDER

Application No. 41333 Permit No. 30862
IN NAME OF

RICHARD L. HOFRICHTER

Surveyed 16 Nov. 1972, by D. NORBY