


T.4S., R.4W., W.M.

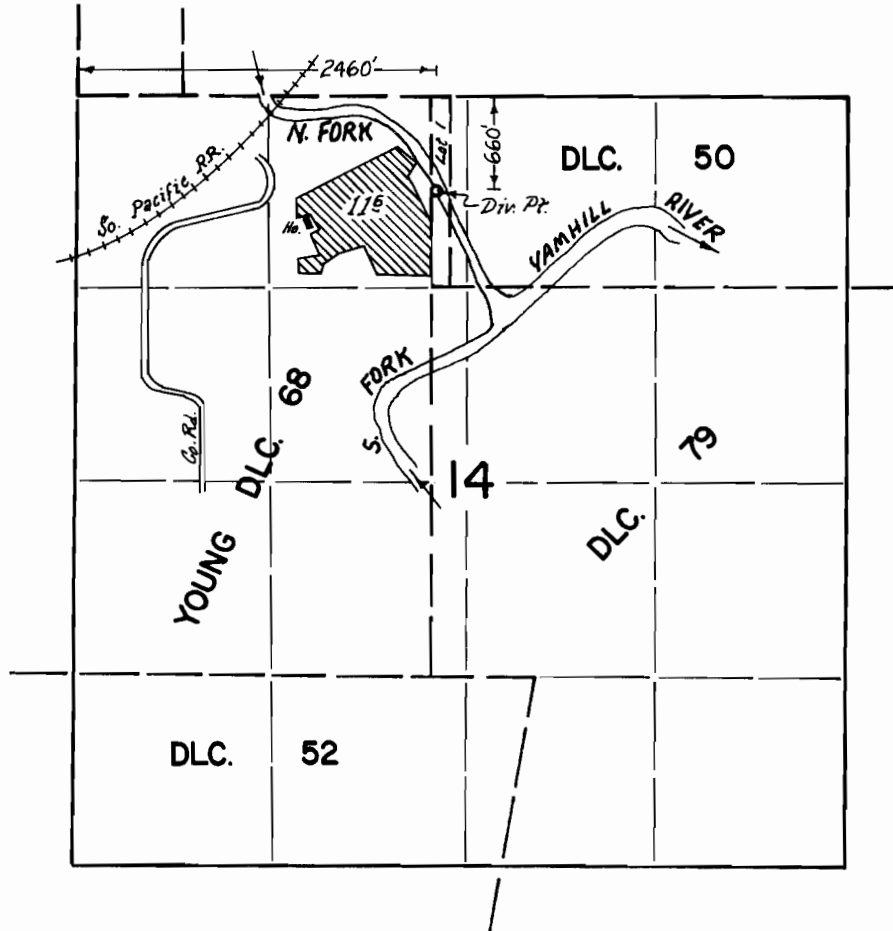

FINAL PROOF SURVEY
UNDER

Application No. 44970 Permit No. 33613
IN NAME OF

CHESTER J. GIBSON

Surveyed 15 Nov. 1972, by D. NORBY