


# T.4 S., R.3 W., W.M.

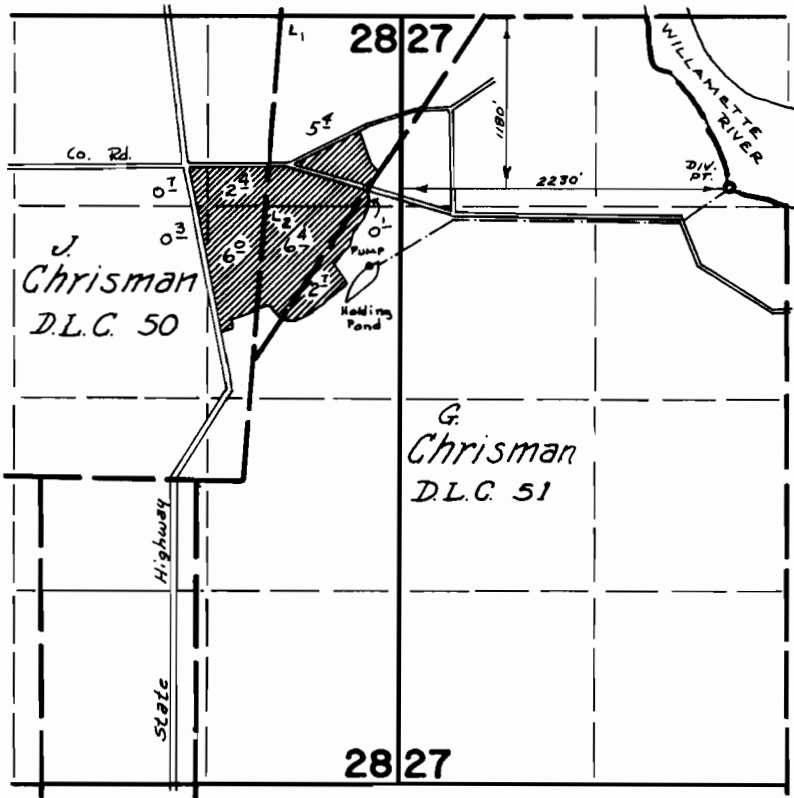

## FINAL PROOF SURVEY UNDER

Application No. 46791 Permit No. 34991  
IN NAME OF

HUBERT L. WILSON

Surveyed Oct. 26 1972, by D. Norby