


T.4 S., R.3 W., W.M.

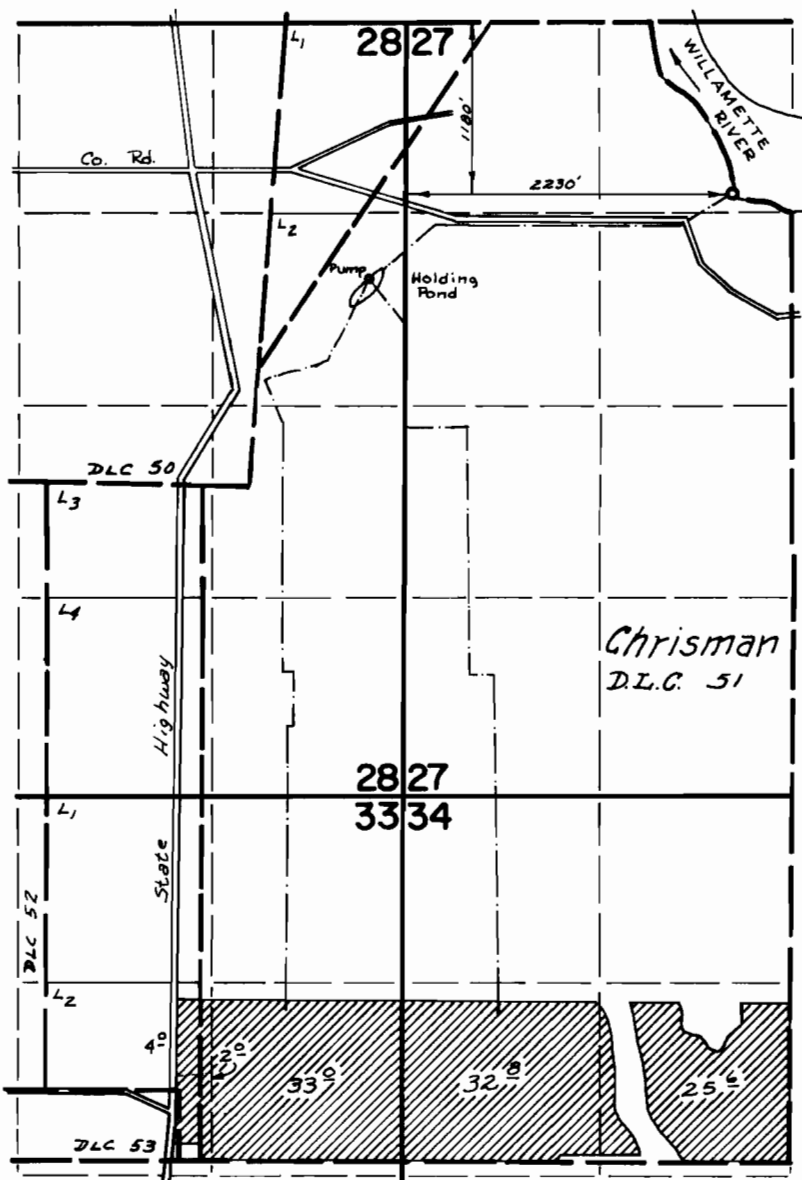

FINAL PROOF SURVEY UNDER

Application No. 46792 Permit No. 34992
IN NAME OF

HUBERT L. WILSON

Surveyed Oct. 27 1972, by D. Norby