



# T. 5 S., R. 4 W., W.M.

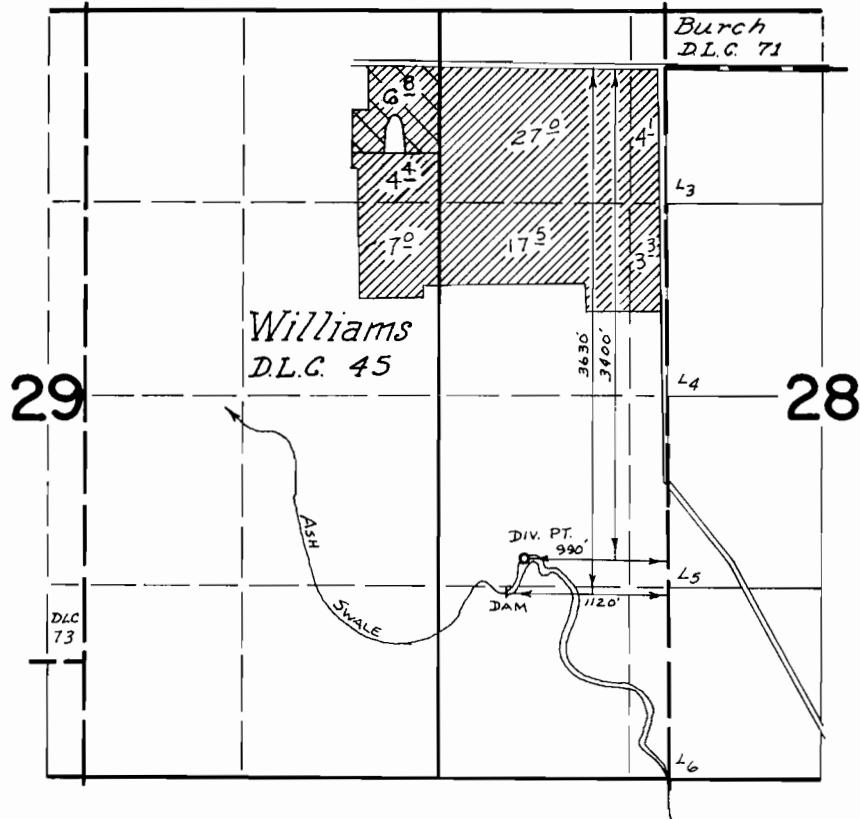

## FINAL PROOF SURVEY UNDER


	51672	38535	
	40250	29822	
Application No. ....	47062	Permit No. ....	

IN NAME OF

**ESTATE OF IVAN C. ROBISON**

Surveyed May 15 1972 by D. Norby  
June 7 1976 R.G. Mucken

# T. 5 S., R. 4 W., W.M.

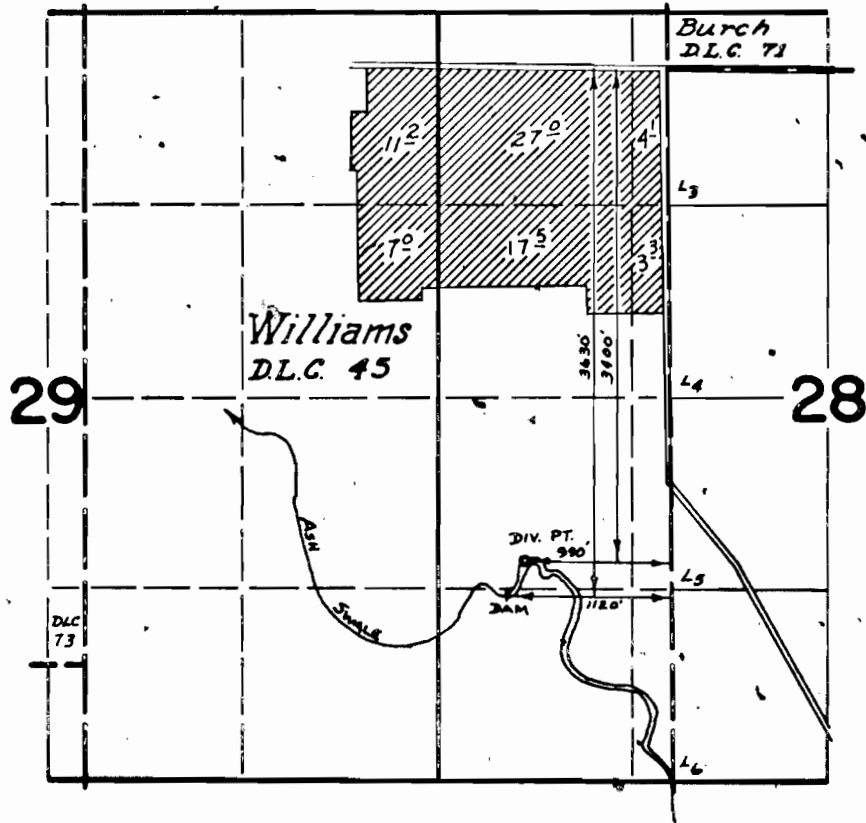

## FINAL PROOF SURVEY UNDER

Application No: 40250 47062 Permit No. 29822 35198  
IN NAME OF

IVAN C. ROBISON

Surveyed May 13 1972, by D. Norby