


T.4S., R.3W., W.M.

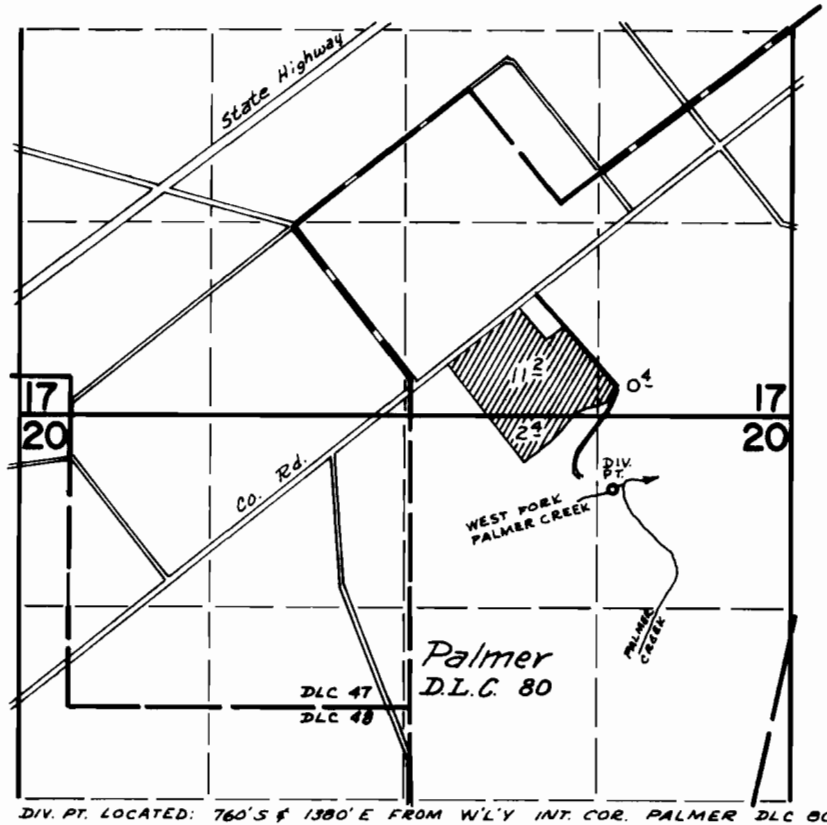

FINAL PROOF SURVEY UNDER

Application No. 47156... Permit No. 35305..
IN NAME OF

FRANCIS L. PATTERSON

Surveyed Oct. 27 1972, by D. Norby