


T.4S., R.4W., W.M.

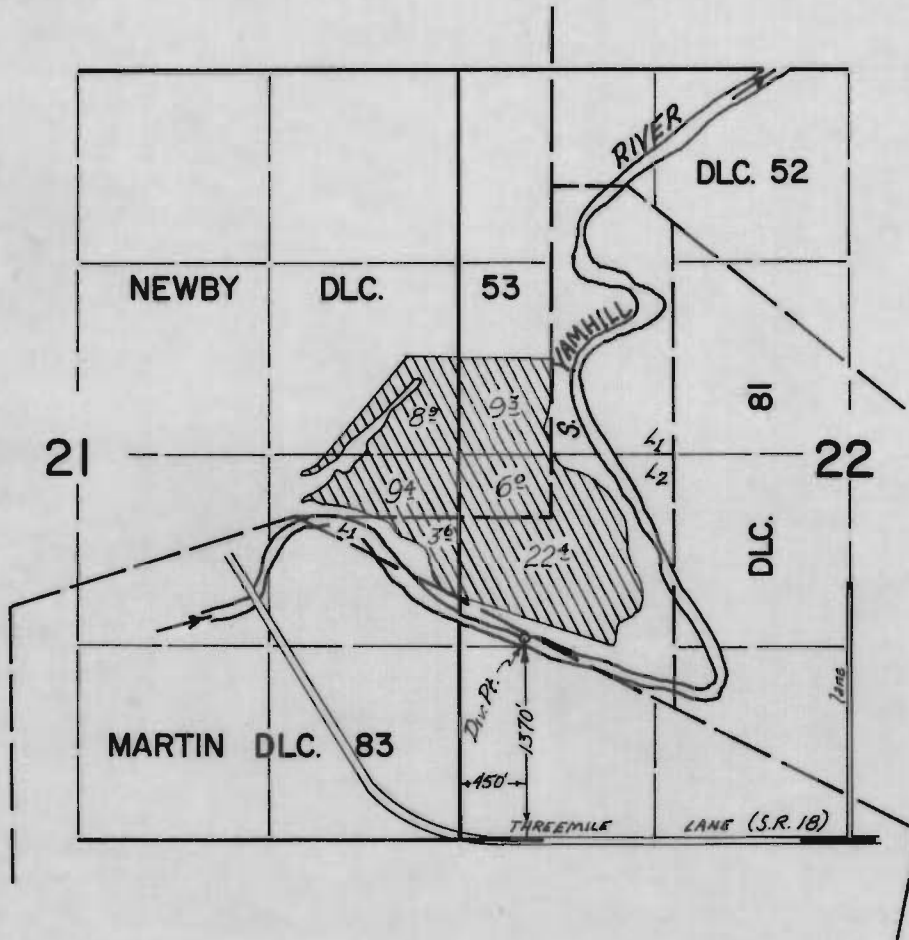

FINAL PROOF SURVEY
UNDER

Application No. 47778 Permit No. 35801
IN NAME OF

ALBERT RICHARD MILLER

Surveyed 16 Nov. 19 72, by D. NORBY