


T.5 S.R.3 W.W.M.

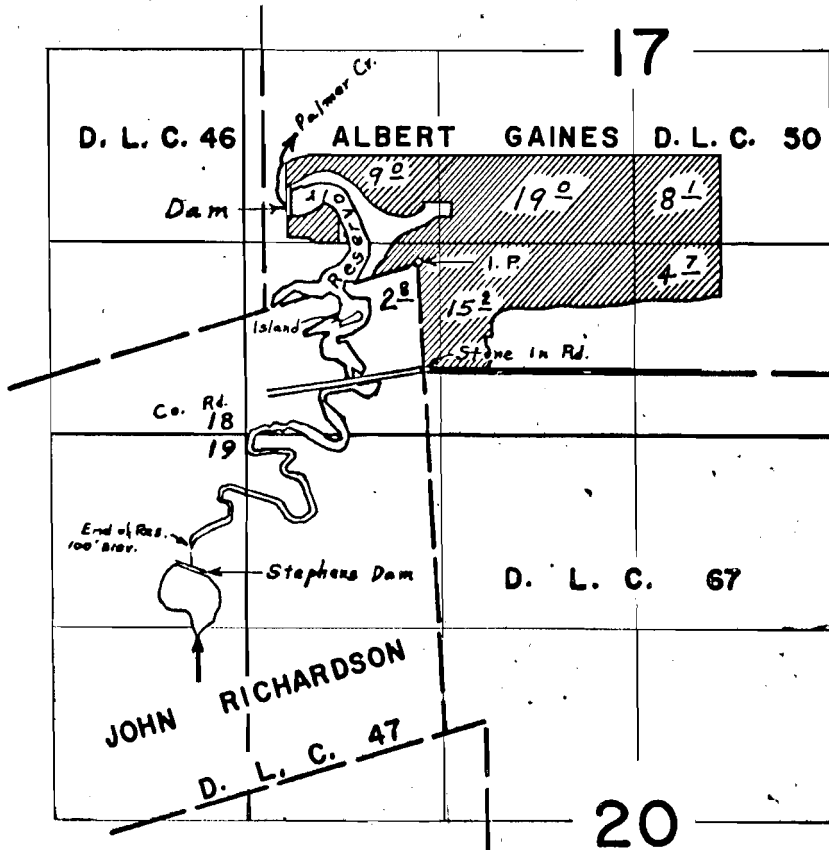

Div. Pt. Located 390' N. & 870' W. From the NE. Cor. Richardson DLC 47

FINAL PROOF SURVEY

UNDER

R-45955

R-5466

45956

34327

R-41619

R-4683

Application No. 41620 Permit No. 31035

IN NAME OF

X. J. & IDA M. DAUENHAUER

Surveyed April 12, 1967, by L.E. Gauld

Nov. 9, 1972

D. NORBY