


# T.8S. R.46 E. W.M.

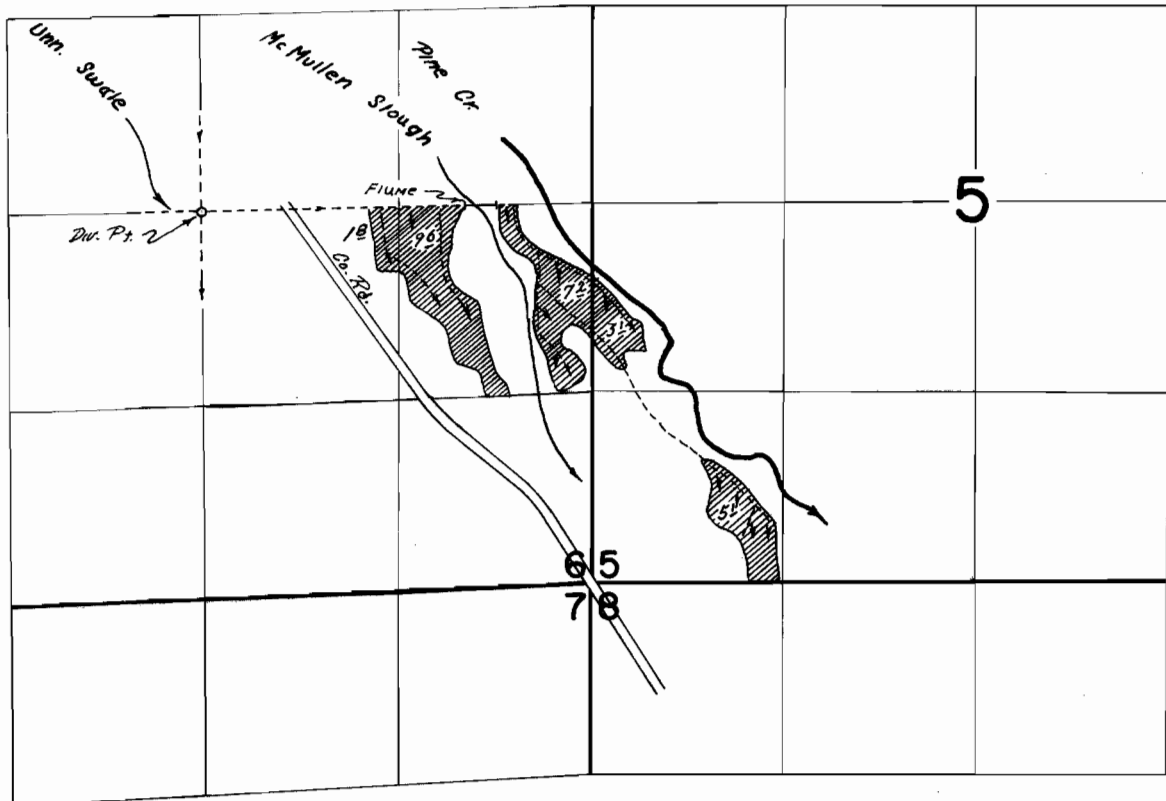

Div. Pt. Loc. At Center Sec. 6

## FINAL PROOF SURVEY UNDER

Application No. 41744 Permit No. 31163  
IN NAME OF

*DERRAL J. THOMAS*

Surveyed JUNE 24 1972, by R. G. MUCKEN