


T. 27 & 28 S. R. 14 W. W.M.

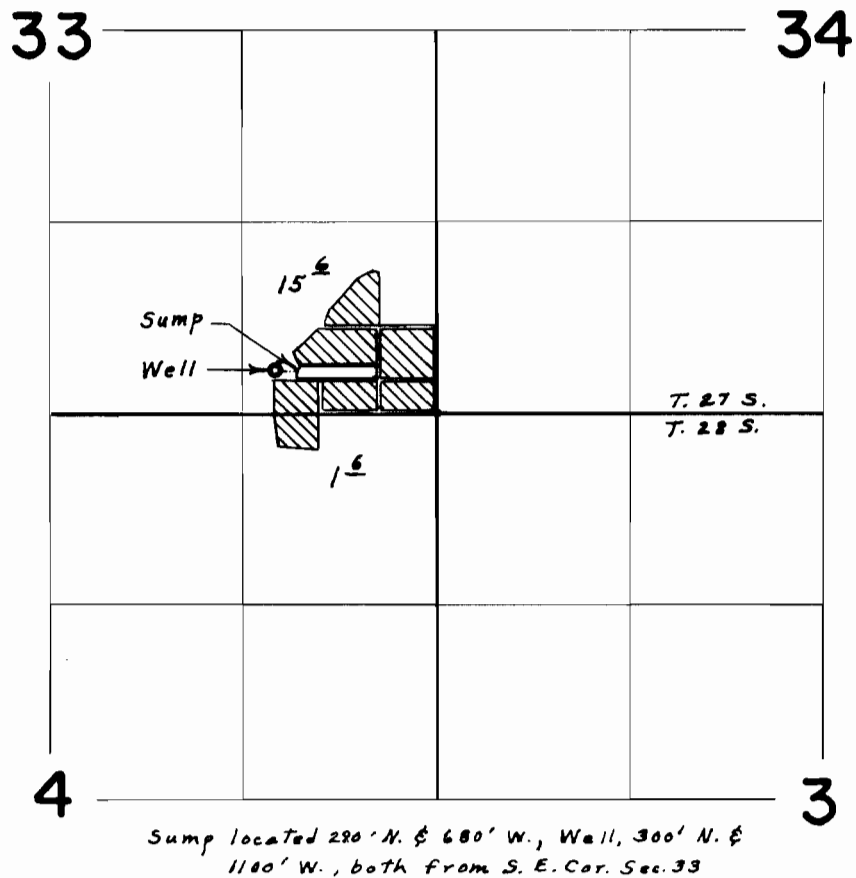

FINAL PROOF SURVEY UNDER

Application No. G-3695 Permit No. G-3498
IN NAME OF

OWEN A. BARTON

Surveyed April 14, 1972, by L. E. Gould.