


T.28 & 29 S.R.14 W.W.M.

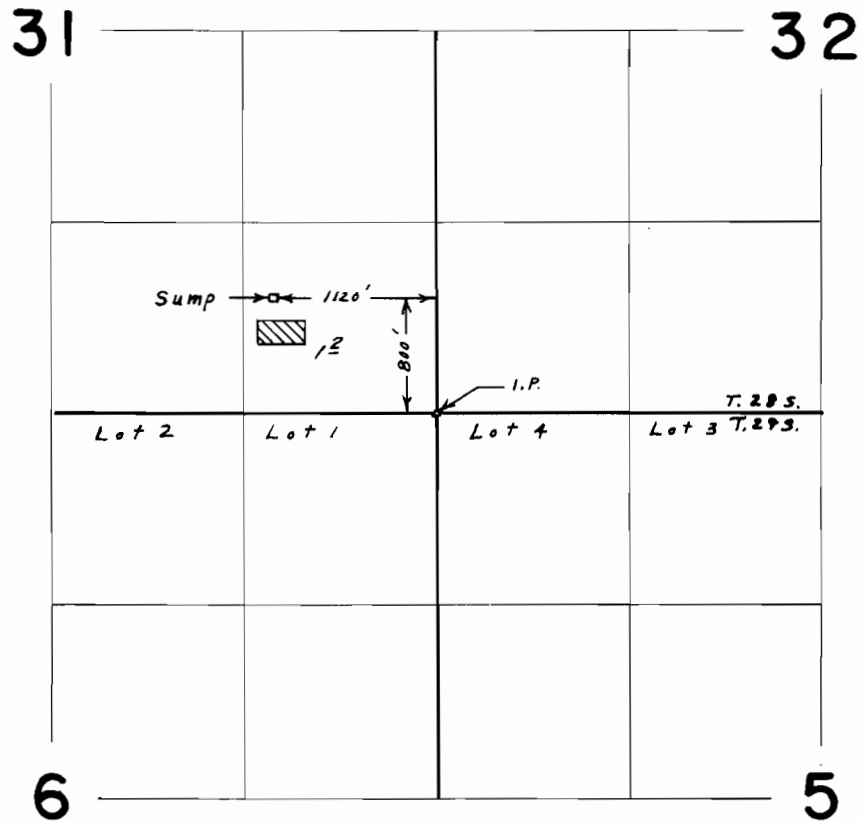

**FINAL PROOF SURVEY**  
UNDER

Application No. G-4616 Permit No. G-4339  
IN NAME OF

DAVID & LEONA BEERS

Surveyed April 17, 1972., by J. E. Gould