


T. 27 S., R. 12 W., W.M.

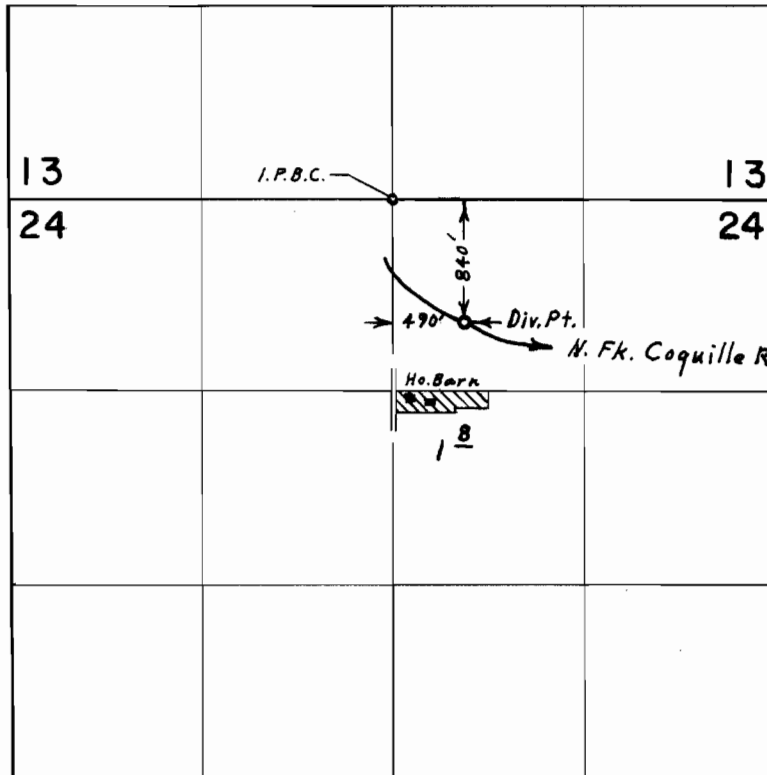

**FINAL PROOF SURVEY**  
UNDER

Application No. 39499 Permit No. 29319  
IN NAME OF

VERN & VIOLET HATCHER

Surveyed July 11, 1972, by L. E. Gould