


T.28S.,R.11W.,W.M.

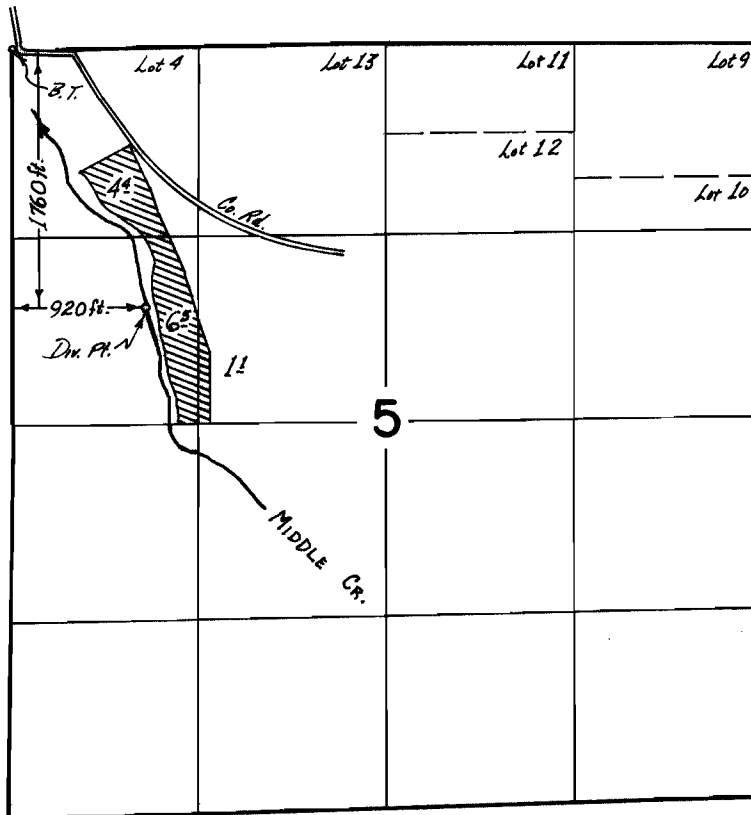

FINAL PROOF SURVEY
UNDER

Application No. 39614 Permit No. 29436
IN NAME OF

RICHARD A. SHIELDS

Surveyed 15 July 1972, by L. E. Gould