


T.27&28S., R11W., W.M.

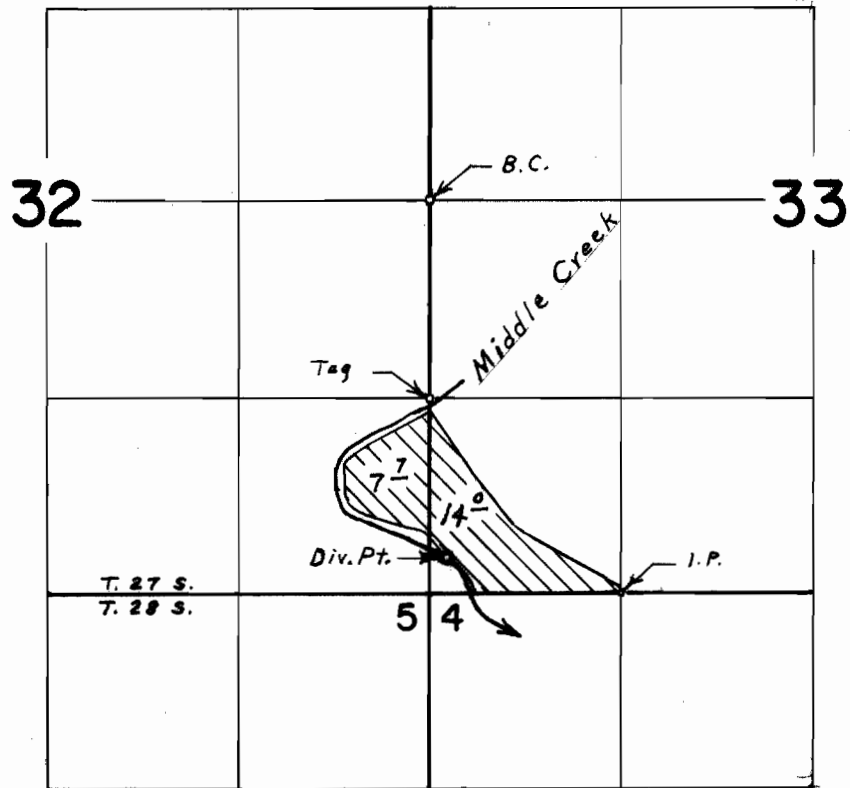

Div. Pt. located 2460' S. & 120' E. from W. 1/4 Cor. Sec. 33

FINAL PROOF SURVEY
UNDER

Application No. 39633 Permit No. 29450
IN NAME OF

REUBEN W. &/OR HILDA G. BROWN

Surveyed July 11, 1972, by L. E. Gould