


T.28 S., R.13 W., W.M.

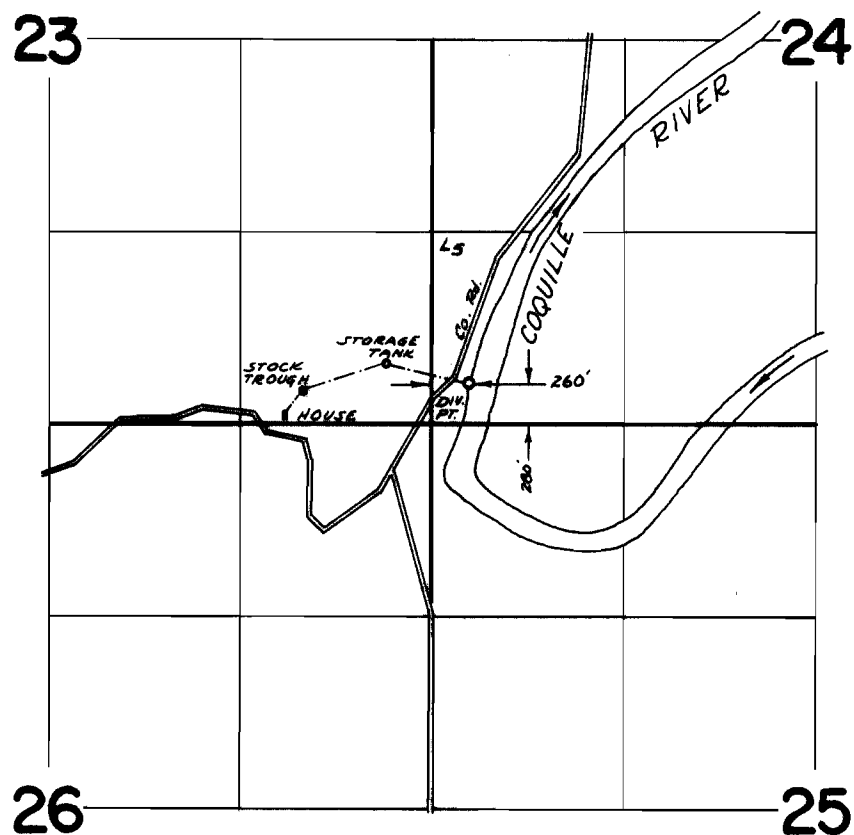

FINAL PROOF SURVEY
UNDER

Application No. 39657 Permit No. 29463
IN NAME OF

ROY F. and/or ELELEDA B. ROBISON

Surveyed July 10 1972, by L.E. Gould